IREDELL COUNTY HEALTH DEPARTMENT

STATESVILLE 704-878-5305 MOORESVILLE 70

IMPROVEMENT PERMIT / AUTHORIZATION TO CONSTRUCT / OPERATION PERMIT / EXISTING SYS.

PERMIT# 068166 PIN# 4628 91 9058 DATE

OWNER OR CONTRACTOR Ralph Bissell PHONE: Business 660-1271 Home

ADDRESS 106 Holycock Lane Mooresville, NC 28117

LOCATION 150 W to Headsell TR Hermance TR Holycock down hill, 1st drive

SUBDIVISION C+T BLOCK / SECTION 11 LOT 1127 LOT AREA 3.62 AC SITE CLASS. #5 DESIGN FLOW 360 L.T.A.R. .3

Septic Tank: 1000 Gallons; STB 825 Date 3/11/98
Pump Tank: 1000 Gallons; PT 47 Date 3/11/98
Pump Make: ZOELLER Model E145C Serial No. 8/27/98
Nitrification Field: No Fields ___ Square Feet ___ Linear Feet ___
No Lines 4 Trench Width 36" Max Trench Bottom Depth 46" Gravel Depth 12"

☒ New System ☐ Repair System Type: I, II, (III), IV, V, VI
System Description: Pressure — Conventional
Repair System Description: Same
Maintenance Agreement Required: ☐ Yes ☐ No


☒ House/Mod. Home No. Bedrooms 3
☐ Mobile Home No. Bathrooms 3
☐ Business No. Employees ___
☐ Other ___
☐ Slab ☐ Crawl Space ☒ Basement w/plumbing ☐ Basement wo/plumbing

Water Supply: ☒ Individual ☐ Public ☐ Community


Comments:/Conditions:

Comments:/Conditions:
76 TDH - 30 cm.

INITIAL SITE SKETCH

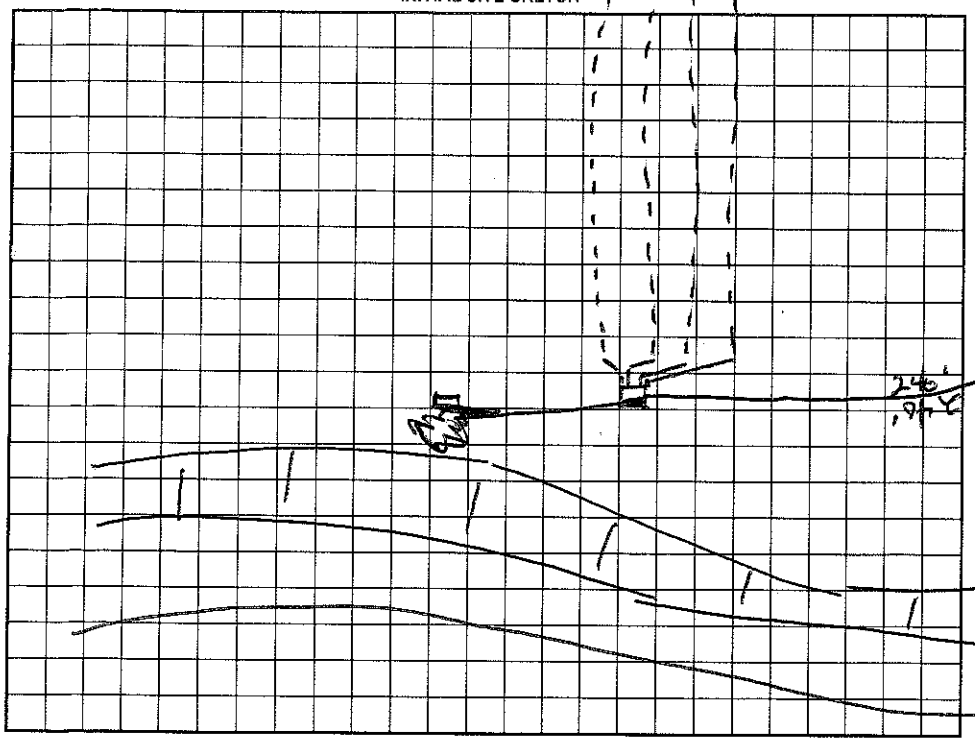

AS BUILT SKETCH

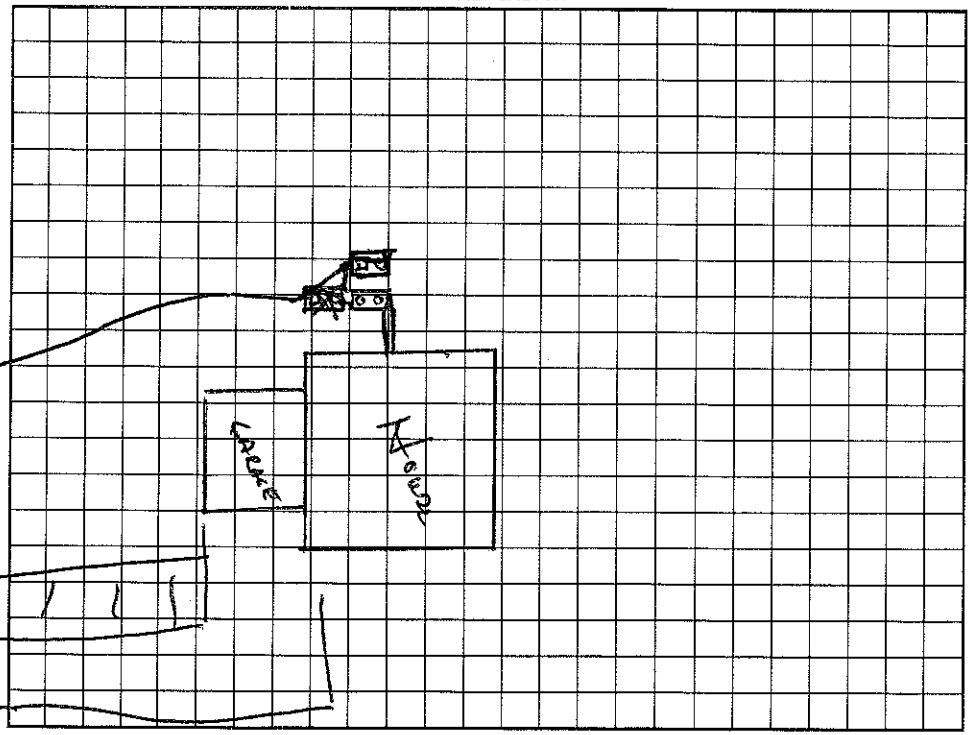

Permit can be suspended or revoked if any false information is supplied toward securing the permit/any unauthorized changes are made to the site/any unauthorized changes are made in the installation of the system. Improvement Permit with plat valid without expiration. Improvement Permit with site plan valid for sixty months. Authorization to Construct is valid for a period equal to that of Improvement Permit – not to exceed sixty months.

Signed: ___ date ___ Installed by: Delbert Bostian

Improvement Permit by: ___ date ___ Operation Permit by: Wesley Sparks R.S. date 6/28/99

Authorization to Construct by: ___ date ___ Existing System Inspection by: ___ date ___

HEALTH DEPT. COPY: WHITE OWNER COPY (FINAL): YELLOW OWNER COPY (INITIAL): PINK