IREDELL COUNTY HEALTH DEPARTMENT

STATESVILLE 704-878-5305 — MOORESVILLE 704-664-5281

IMPROVEMENT PERMIT / AUTHORIZATION TO CONSTRUCT / OPERATION PERMIT / EXISTING SYSTEM INSPECTION

PERMIT# 121494 PIN# 4628 93 6254 DATE 1-7-05

OWNER OR CONTRACTOR Alice & Robert Sumner PHONE: Business 796-8968 Home 786-2902

ADDRESS 630 Windsor Place NE Concord, NC 28025

LOCATION Hwy 150 W TR Waddle TR Hermance near end on left

SUBDIVISION Jay T BLOCK / SECTION II LOT 25 LOT AREA _____ SITE CLASS. _____ DESIGN FLOW 240 gpd T.A.R. Existing

Install New Septic Tank: ≥1000 Gallons; STB 338 Date 7-8-05

Pump Tank: _____ Gallons; PT _____ Date _____

Pump Make: _____ Model _____ Serial No. _____

Existing Nitrification Field: No Fields ___ Square Feet _____ Linear Feet 225'

No Lines Gravel Trench Width Bed ~5X75 Max Trench Bottom Depth _____ Gravel Depth _____

☐ New System ☐ Repair System Type: I, II, III, IV, V, VI

System Description: Existing Gravity Conventional

Repair System Description: Lot deeded prior to 1983

Maintenance Agreement Required: ☐ Yes ☒ No

☒ House/Mod. Home ☐ Mobile Home ☐ Business ☐ Other

No. Bedrooms 2 No. Bathrooms 3 No. Employees ___


☐ Slab ☐ Crawl Space ☒ Basement w/plumbing ☐ Basement wo/plumbing

Water Supply: ☒ Individual Existing ☐ Public ☐ Community


Comments/Conditions: Note! Properly abandoned existing Septic Tank (ST) & install new ST, 25' From basement Wall.

Comments/Conditions: Grinder pump to be used for basement plumbing. Must discharge grinder pump sewage into 4" gravity line 10' or more from connection to ST through lateral line branch

INITIAL SITE SKETCH ☒ Not to Scale

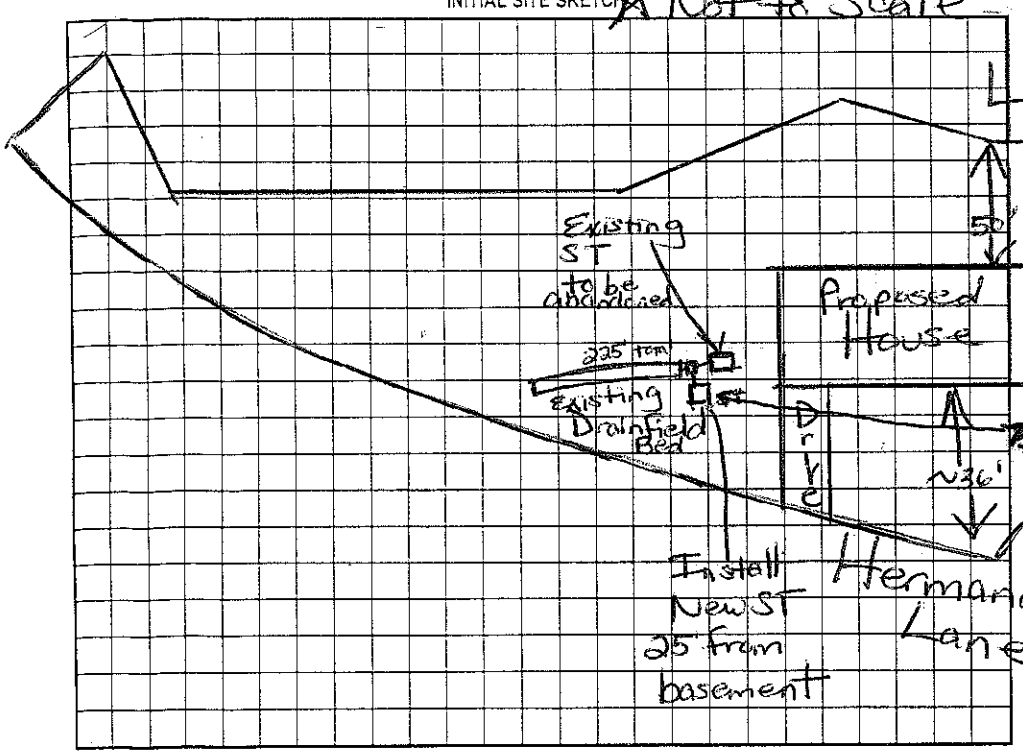

AS BUILT SKETCH

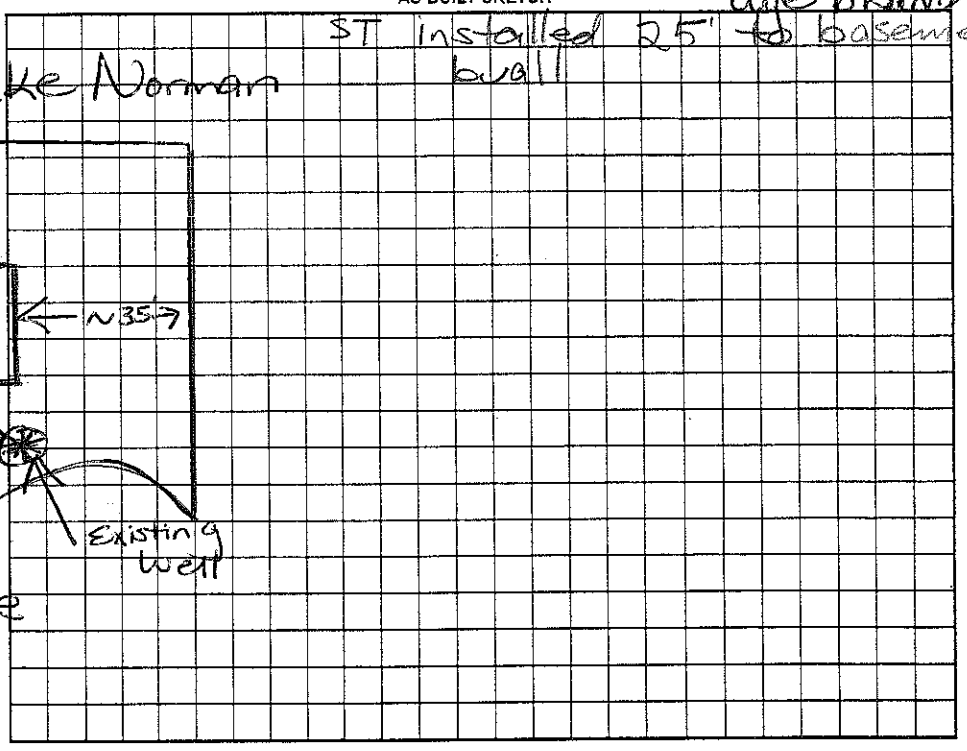

Permit can be suspended or revoked if any false information is supplied toward securing the permit/any unauthorized changes are made to the site/any unauthorized changes are made in the installation of the system. Improvement Permit with plat valid without expiration. Improvement Permit with site plan valid for sixty months. Authorization to Construct is valid for a period equal to that of Improvement Permit – not to exceed sixty months.

Signed: Alice E. Sumner date 1-10-05

Improvement Permit by: Maine H. Dotson RS date 1/7/05

Authorization to Construct by: Maine H. Dotson RS date 1/7/05

Installed by: Larry Tickle

Operation Permit by: Maine H. Dotson RS date 8/24/05

Existing System Inspection by: _____ date _____

HEALTH DEPT. COPY: WHITE OWNER COPY (FINAL): YELLOW OWNER COPY (INITIAL): PINK