185W

IREDELL COUNTY HEALTH DEPARTMENT

STATESVILLE 704-878-5305 MOORESVILLE 704-664-5281

IMPROVEMENT PERMIT / AUTHORIZATION TO CONSTRUCT / OPERATION PERMIT / EXISTING SYSTEM INSPECTION

PERMIT# 130556 PIN# 4628 93 7433 DATE 1/17/06

OWNER OR APPLICANT Arnold + Mary Graham PHONE: Business 239-242-2627 Home 704-226-3114

ADDRESS 128 Pavilion Ln, Mooresville, NC. 28117

LOCATION 308 Hermance Rd.

SUBDIVISION CL+T BLOCK / SECTION 11 LOT 248 LOT AREA .63 SITE CLASS. PS DESIGN FLOW 360 L.T.A.R. .25

Septic Tank: 1000 Gallons: STB 1012 Date 5/28/05
Pump Tank: 1000 Gallons: PT 27 Date 11/14/06
Pump Make: Goulds Model WE3-3122 Serial No. L060931L
Nitrification Field: No Fields ___ Square Feet 480 Linear Feet 240
No Lines 4@60' Trench Width 2' Max Trench Bottom Depth 12" Gravel Depth No

☐ New System ☐ Repair ☒ Expansion System Type: I II III IV V VI
System Description: PM → 8" Large Dia. Pipe
Repair System Description: ___
Maintenance Agreement Required: ☐ Yes ☒ No
☐ Gravity ☒ Pressure ☐ Slab ☐ Crawl Space ☒ Basement w/plumbing ☐ Basement wo/plumbing


☒ House/Mod. Home No. Bedrooms 3
☐ Mobile Home No. Persons ___
☐ Business No. Employees ___
☐ Other ___

Water Supply: ☒ Individual ☐ Public ☐ Community

Comments:/Conditions: (1) (X) OLD WELL MUST BE PROPERLY ABANDONED FIRST THING. (2) ADDITIONAL 6" OF SUITABLE COVER MATERIAL IS REQUIRED ON THIS SYSTEM

Comments:/Conditions: 2-23-07 - Vd S/T + P/T ws
8" FIBER WOUNDED PIPE w/ Pre-Manifold

INITIAL SITE SKETCH

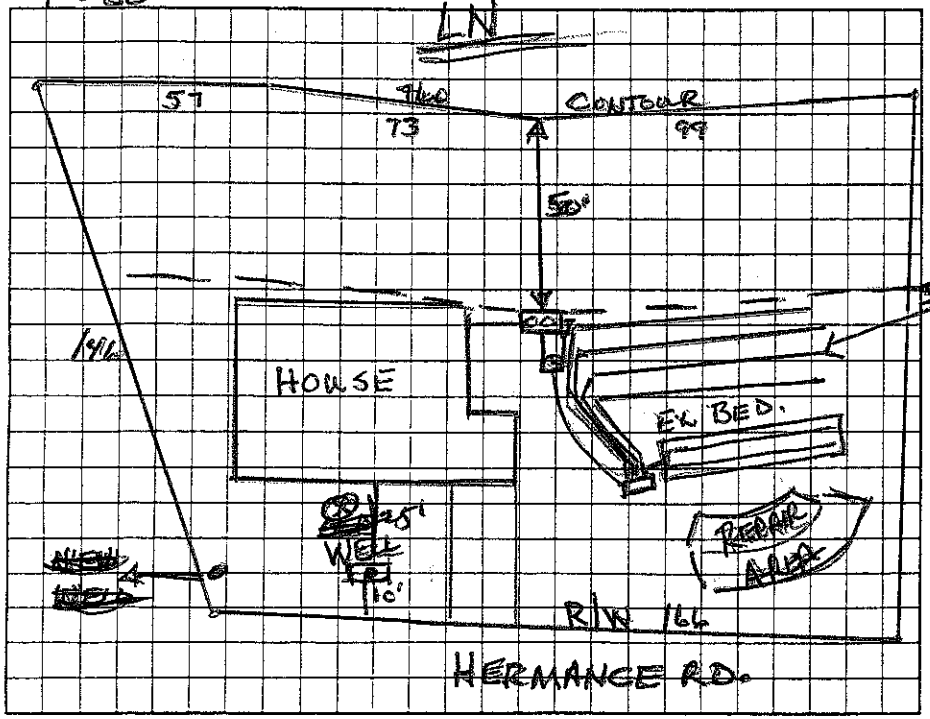

AS BUILT SKETCH

Permit can be suspended or revoked if any false information is supplied toward securing the permit/any unauthorized changes are made to the site/any unauthorized changes are made in the installation of the system. Improvement Permit with plat valid without expiration ☐ Improvement Permit with site plan valid for sixty months ☐ Authorization to Construct is valid for a period equal to that of Improvement Permit – not to exceed sixty months.

Signed: Mary Graham date ___ Installed by: R+H

Improvement Permit by: Wesley Sparks R.S. date 1/18/07 Operation Permit by: Wesley Sparks R.S. date 5/13/08

Authorization to Construct by: Wesley Sparks RS date 1/18/07 Existing System Inspection by: ___ date ___

HEALTH DEPT. COPY: WHITE OWNER COPY (FINAL): YELLOW OWNER COPY (INITIAL): PINK