4628949637

IREDELL COUNTY HEALTH DEPARTMENT

STATESVILLE 704-878-5305 MOORESVILLE 704-664-5281

IMPROVEMENT PERMIT / CERTIFICATE OF COMPLETION / OPERATION PERMIT / EXISTING SYSTEM INSPECTION

PROPERTY DESCRIPTION NO. 16365 DATE 6/14/93 TAX MAP NO. 2N 1A 195

OWNER OR CONTRACTOR Dwight Windsor PHONE: Business 872-2400 Home

ADDRESS Robinson Rd. Mooresville

LOCATION Robinson Rd. ~ .7 mile TL on gravel to next to last house (L)

SUBDIVISION CL+T BLOCK / SECTION 11 LOT 195 LOT AREA .8 SITE CLASS. P L.T.A.R. .25 - .3

Water Supply: ☐ Individual ☐ Community ☐ Public

Septic Tank: 1000 Gallons; STB 358 Date 2/6/93

Pump Tank: Gallons; PT Date

Nitrification Field: No Fields N/A Square Feet EXISTING SYSTEM Linear Feet

No Lines Trench Width Trench Depth Gravel Depth

☐ New System ☑ Repair System Type: I, II (III) IV, V, VI

System Description: EXISTING SYSTEM

Repair System Description:

Maintenance Agreement Required: ☐ Yes ☑ No

☑ House/Mod. Home No. Bedrooms 3 Garbage Disposal: ☐ Yes ☑ No

☐ Mobile Home No. Bathrooms 2 Auto. Dishwasher: ☑ Yes ☐ No

☐ Business No. Employees Auto. Washing Machine: ☑ Yes ☐ No


☐ Other Other

☐ Slab ☑ Crawl Space ☐ Basement w/plumbing ☐ Basement wo/plumbing

Comments Old Tank Removed so house can be constructed

INITIAL SITE SKETCH

AS BUILT SKETCH

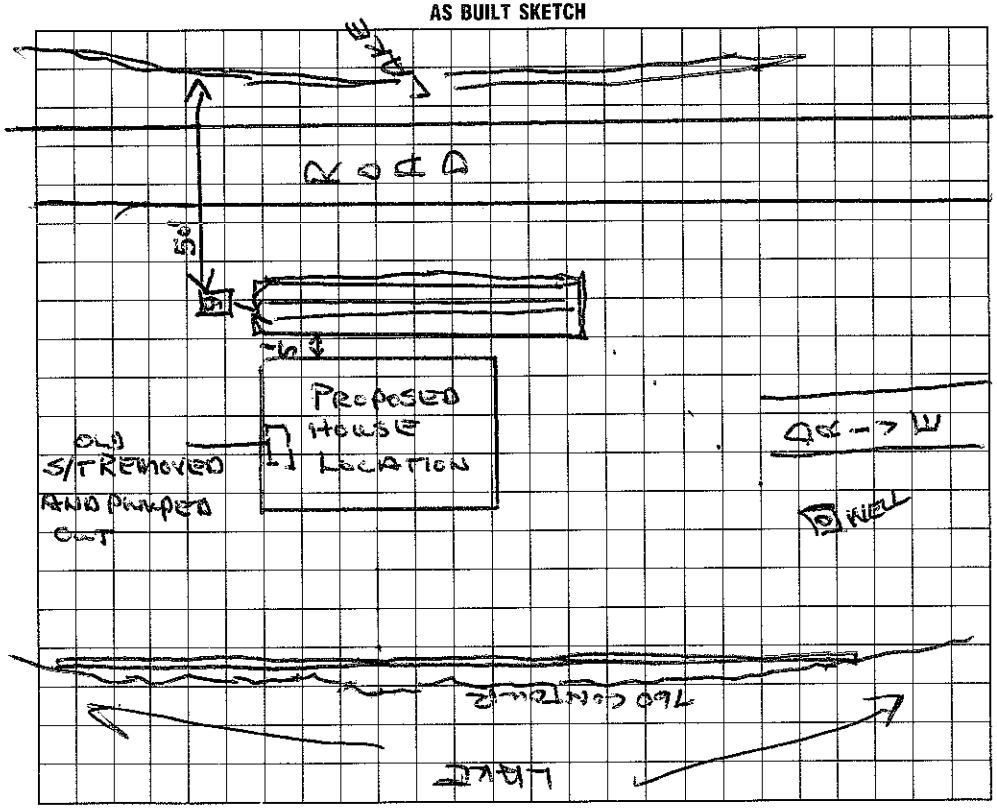

I understand that this permit can be suspended or revoked if any false information is supplied toward securing the permit/any unauthorized changes are made to the site/any unauthorized changes are made in the installation of the system. Improvement Permit is valid for 60 months from date of issuance.

Signed:

Improvement Permit by: date

Existing System Inspection by: date

Installed by: Barry Sigmon

Certificate of Completion by: Wesley Sparks E.S. date 6/14/93

Operation Permit by: date

HEALTH DEPT. COPY: WHITE INSPECTION COPY (FINAL): GREEN OWNER COPY (FINAL): YELLOW INSPECTION COPY (INITIAL): PINK OWNER COPY (INITIAL): GOLD