IREDELL COUNTY HEALTH DEPARTMENT

STATESVILLE 704-878-5305 MOORESVILLE 704-664-5281

IMPROVEMENT PERMIT / AUTHORIZATION TO CONSTRUCT / OPERATION PERMIT / EXISTING SYSTEM INSPECTIO

2.30-3.0

PERMIT# 118352 PIN# 4628963699 Cell 564-8806 DATE 2-20-04

OWNER OR CONTRACTOR ~~Linda Tucker~~ Lazzio Szoecs PHONE: Business 564-8807 Home 528-0008 or 483-3651

ADDRESS P.O. Box 95 Sherrills Ford, NC 28673

LOCATION Hwy 150 West TR Perth Rd TL Fern Hill to end Point of View Dr on right across From lake access

SUBDIVISION Point of View BLOCK / SECTION ____ LOT 15 LOT AREA 1.2 Acre SITE CLASS PS DESIGN FLOW 360gpd L.T.A.R. .3 Area

Septic Tank: 1000 Gallons; STB 354 Date 7/1/04

Pump Tank: ____ Gallons; PT ____ Date ____

Pump Make: ____ Model ____ Serial No. ____

Nitrification Field: No Fields 1 Square Feet 1200' Linear Feet 400'

No Lines 4@100' Trench Width 36" Max Trench Bottom Depth 36" Gravel Depth 12"

[X] New System [ ] Repair System Type: I, II, III, IV, V, VI

System Description: Gravity-Conventional

Repair System Description Grav/Pump Panel Blk

Maintenance Agreement Required: [ ] Yes [X] No

[X] House/Mod. Home [ ] Mobile Home [ ] Business [ ] Other

No. Bedrooms 3 No. Bathrooms 2.5 No. Employees ____

[ ] Slab [X] Crawl Space [ ] Basement w/plumbing [ ] Basement wo/plumbing


Water Supply: [X] Individual [ ] Public [ ] Community

Comments./Conditions:

Comments:/Conditions: Keep Septic System 10' From PL

Note: Neighbor's Well on lot 16 is 40' From PL

INITIAL SITE SKETCH

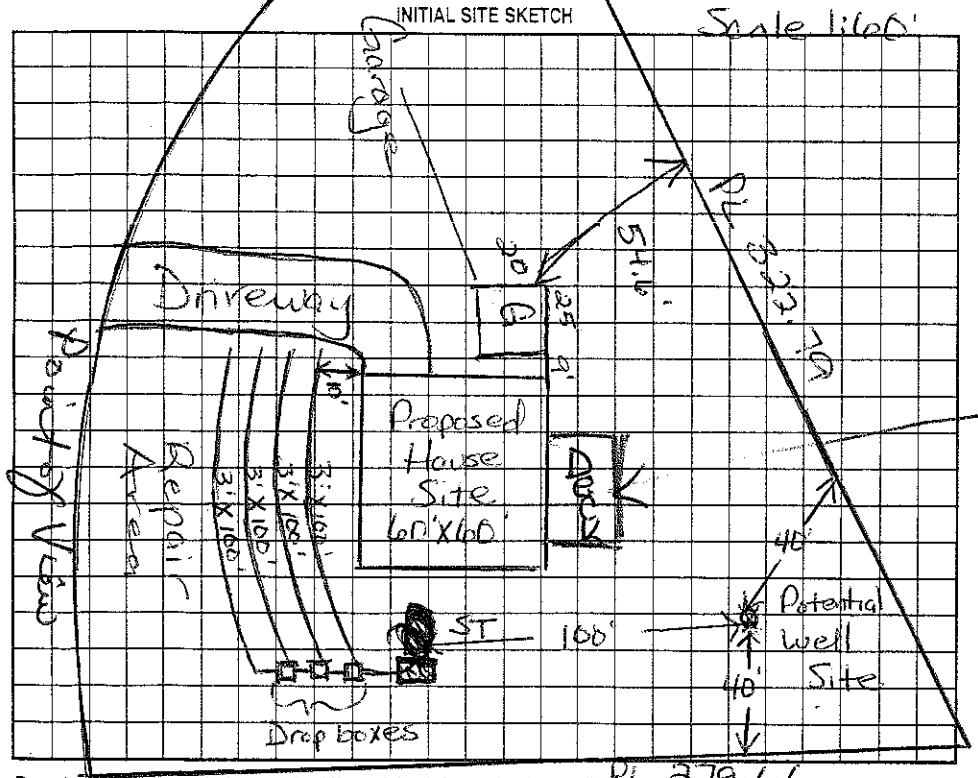

AS BUILT SKETCH

Location of the proposed 18'X34' Deck addition does not appear to impact the existing on-site septic system.**NOTE: Must keep at least 25ft from well

Maria Dotson REHS

Date: 4/12/13

ICHD-Environmental Health Division

The proposed / existing Garage addition does not appear to impact the existing septic system

**NOTE: Garage must be at least 25 from well

Maria Dotson REHS

Date: 11/18/2011

ICHD-Environmental Health Division

Permit can be suspended or revoked if any false information is supplied toward securing the permit/any unauthorized changes are made to the site/any unauthorized changes are made in the installation of the system. Improvement Permit with plat valid without expiration. Improvement Permit with site plan valid for sixty months. Authorization to Construct is valid for a period equal to that of Improvement Permit – not to exceed sixty months.

Signed Linda Tucker date 2/24/04

Improvement Permit by: Maria H. Dotson R.S. date 2/20/04

Authorization to Construct by: Maria H. Dotson R.S. date 2/20/04

Installed by: D+M Enterprises

Operation Permit by: Wesley Sparkes R.S. date 8/25/04

Existing System Inspection by: ____ date ____

HEALTH DEPT. COPY: WHITE OWNER COPY (FINAL): YELLOW OWNER COPY (INITIAL): PINK