IREDELL COUNTY HEALTH DEPARTMENT

STATESVILLE 704-878-5305 MOORESVILLE 704-664-5281

IMPROVEMENT PERMIT / CERTIFICATE OF COMPLETION / OPERATION PERMIT / EXISTING SYSTEM INSPECTION

PROPERTY DESCRIPTION NO. 17927 DATE 4/14/94 TAX MAP NO. 2N 6A 14 4628-96-3844 Watershed: ☑ Yes ☐ No

OWNER OR CONTRACTOR JERRY W MORRIS PHONE: Business _____ Home 881-0030

ADDRESS 2646 VINES CREEK DR STATESVILLE, NC. 28677

LOCATION FERN HILL RD - INTO PT OF VIEW ON

SUBDIVISION PT OF VIEW BLOCK / SECTION _____ LOT 14 LOT AREA ~.97 SITE CLASS. P. DESIGN FLOW 360 L.T.A.R. 25 ; 3

Septic Tank: 1000 Gallons; STB 744 Date 4/2/94

Pump Tank: 1000 Gallons; PT 24 Date 4/1/94

Pump Make: _____ Model _____ Serial No. _____

Nitrification Field: No Fields 1 Square Feet 1260 Linear Feet 420

No Lines 6@67 Trench Width 3' Max Trench Bottom Depth 24" Gravel Depth 12"

☑ New System ☐ Repair System Type: I, II, III, (IV) V, VI

System Description: PRES. CONVENTIONAL

Repair System Description: GRAVITY PANEL

Maintenance Agreement Required: ☑ Yes ☐ No

☑ House/Mod. Home No. Bedrooms 3

☐ Mobile Home No. Bathrooms 2

☐ Business No. Employees _____

☐ Other _____


☐ Slab ☑ Crawl Space ☐ Basement w/plumbing ☐ Basement wo/plumbing

Water Supply: ☑ Individual ☐ Community ☐ Public

Comments:
6@67'X3'
2"PVC w 3/16" HOLES ON 5" CNTRS
24" MAX TRENCH DEPTH
67'X3'=201'
506PM PUMP
(100-110 GAL PER DOSE-MAX

Comments:
Installed as shown on IP.

INITIAL SITE SKETCH

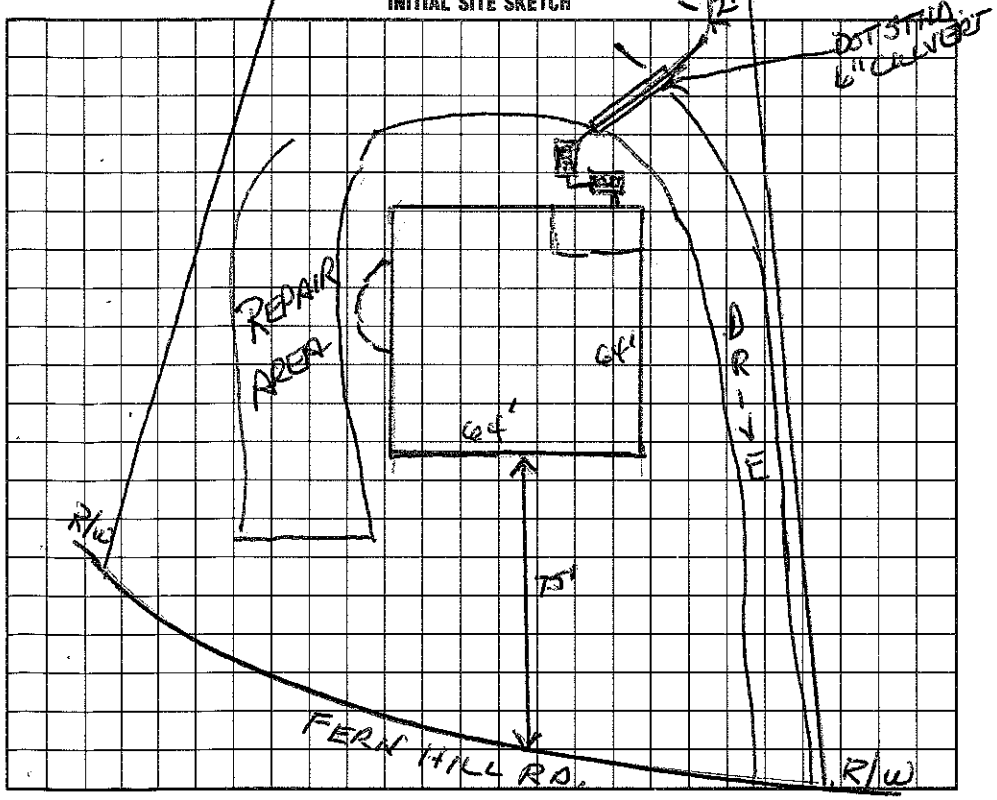

AS BUILT SKETCH

I understand that this permit can be suspended or revoked if any false information is supplied toward securing the permit/any unauthorized changes are made to the site/any unauthorized changes are made in the installation of the system. Improvement Permit is valid for 60 months from date of issuance.

Signed: Jerry Hernandez

Improvement Permit by: Wesley Sparks RS. date 4/14/94

Existing System Inspection by: _____ date _____

Installed by: F J Ervin

Certificate of Completion by: Wesley Sparks RS. date 8/8/94

Operation Permit by: Wesley Sparks RS. date 8/8/94

HEALTH DEPT. COPY: WHITE INSPECTION COPY (FINAL): GREEN OWNER COPY (FINAL): YELLOW INSPECTION COPY (INITIAL): PINK OWNER COPY (INITIAL): GOLD