IREDELL COUNTY HEALTH DEPARTMENT

THIS PERMIT REPLACES PREVIOUS ISSUED 10/23/2006

STATESVILLE 704-878-5305 MOORESVILLE 704-664-5281

IMPROVEMENT PERMIT / AUTHORIZATION TO CONSTRUCT / OPERATION PERMIT / EXISTING SYSTEM INSPECTION

PERMIT # 127395 PIN # 4628-96-3936 DATE JULY 22 2010

OWNER or APPLICANT SELECT PORTFOLIO SERVICING PHONE: Business 801-594-6095 Home: C/O 704-940-1724

OWNER or APPLICANT ADDRESS 3815 SOUTH WEST TEMPLE SALT LAKE CITY, UT 84115

LOCATION / DIRECTIONS NC 150 TO PORTH ROAD, TL FERN HILL ROAD, CONTINUE POINT OF VIEW DRIVE TO END,

SUBDIVISION POINT OF VIEW BLOCK / SECTION LOT # 13 LOT AREA 0.753 DESIGN FLOW 480 L.T.A.R. 0.25 GPD/FT²

Septic Tank EXISTING Gallons: STB Date

Pump Tank EXISTING Gallons: P.T Date

Pump Make Model Serial #

Nitrification Field No Fields 1 No Lines 5 Linear Feet 320

Trench Width 36" 24" Max. Trench Bottom Depth 36" SAND Depth 24"

☑ New System ☐ Repair ☐ Expansion System Type I II III (IV) V VI

System Description: 50% REDUCTION LOW-PRESS.

Repair System Description: 50% REDUCTION, LOW-PRESS

Maintenance Agreement Required ☑ YES ☐ NO

☐ GRAVITY ☑ PRESSURE

☑ Residence No. Bedrooms 4

☐ Business No. Persons

☐ Other No. Employees

☐ Slab ☐ Crawl Space


☑ Basement w/plumbing ☐ Basement w/o plumbing

Water Supply: ☑ Private ☐ Public ☐ Community


Comments / Conditions (1) REMOVE FILL DIRT OVER DRAINFIELD DOWN TO ORIGINAL GRADE (2) REMOVE EXISTING DRAINLINES AND REPLACE WITH 74 PPBPS PANELS AS SHOWN ON CONTOUR, ~~36" TRENCH~~ w/ 6" SAND BENEATH PANELS

Comments / Conditions (3) INSTALL SUBSURFACE INTERCEPT DRAINAGE DITCH AT LOCATION SHOWN BEGINNING 48" DEEP w/ 1% FALL TO DAYLIGHT (4) REMOVE UNCASED DOOR FRAME FROM BONUS ROOM

INITIAL SITE SKETCH

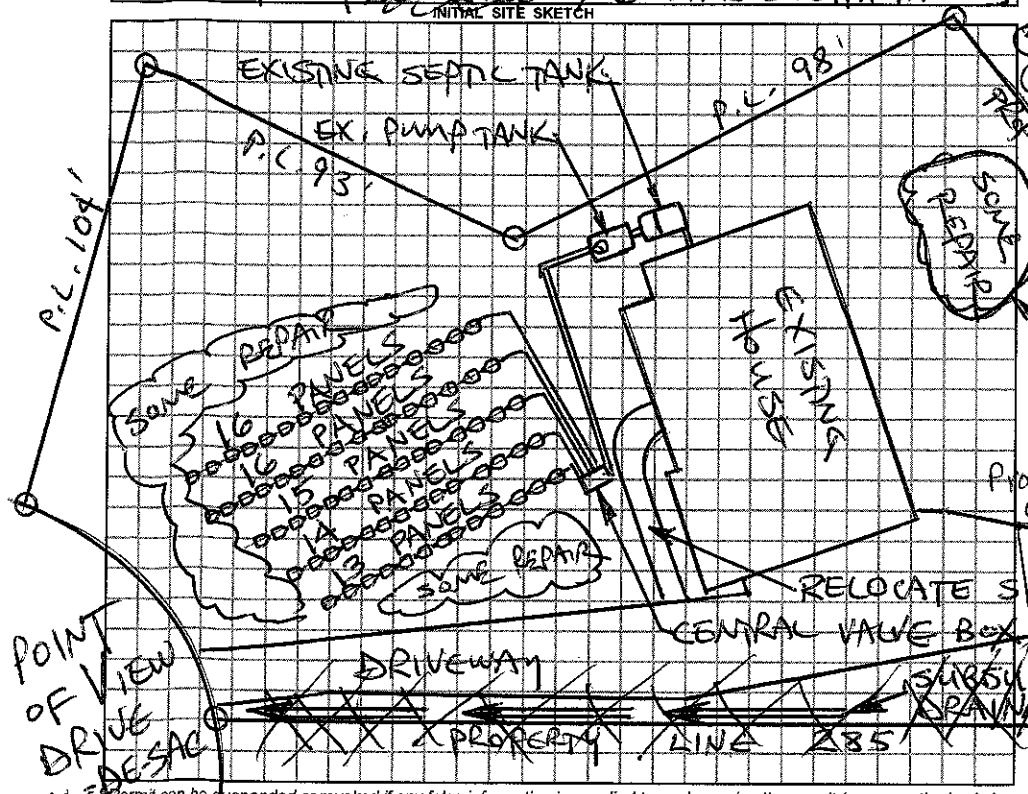

AS BUILT SKETCH

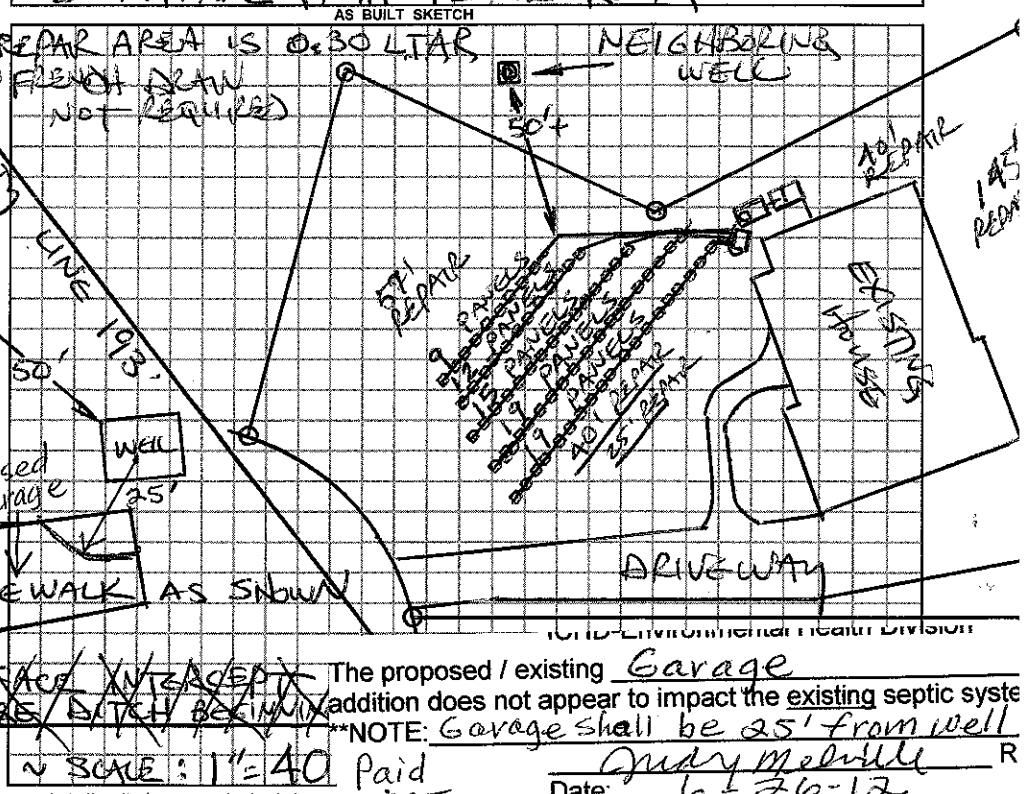

~ SCALE: 1" = 40

The proposed / existing Garage addition does not appear to impact the existing septic syste

**NOTE: Garage shall be 25' from well

R

Judy Melville

Date: 6-26-12

ICHD-Environmental Health Division

Paid $25

Permit can be suspended or revoked if any false information is supplied toward securing the permit / any unauthorized changes are made to the site / any unauthorized change.

☐ IMPROVEMENT PERMIT w/ plat valid without expiration. ☑ IMPROVEMENT PERMIT w/ site plan valid for 60 mos.

☑ AUTHORIZATION TO CONSTRUCT valid for period equal to IMPROVEMENT PERMIT not to exceed 60 mo.

Owner / Applicant Signature: Date 8/3/10

Improvement Permit by: STEVE HEDRICK Date 7/22/2010

Authorization to Construct by: STEVE HEDRICK Date 7/22/2010

Installed by: SEAN PENWARDEN

Operation Permit by: STEVE HEDRICK Date: 2-25-11

Existing System Inspected by: Date:

YOU SHOULD CONTACT A LOCATOR SERVICE PRIOR TO ANY EXCAVATION.

WHITE COPY Environmental Health YELLOW COPY (Final) Owner / Applicant PINK COPY (Initial) Owner / Applicant