IREDELL COUNTY HEALTH DEPARTMENT

STATESVILLE 704-878-5305 MOORESVILLE 704-664-5281

IMPROVEMENT PERMIT / AUTHORIZATION TO CONSTRUCT / OPERATION PERMIT / EXISTING SYSTEM INSPECTION

PERMIT# 127395 PIN# 4628 96 3936 DATE 5/4/05

OWNER OR CONTRACTOR Kate Beaber PHONE: Business 704-201-3546 Home

ADDRESS 108 Tommys Lane Mooresville, NC. 28117

LOCATION Point of View, Perth N TL Fern Hill straight to cul de sac, lot to right of center

SUBDIVISION Point of View BLOCK / SECTION LOT 13 LOT AREA .753 SITE CLASS PS DESIGN FLOW 480 L.T.A.R. .3

Septic Tank: 1000 Gallons; STB 312 Date 4/30

Pump Tank: 1000 Gallons; PT 29 Date 4/25/06

Pump Make: Chanior Model CPE-SA-12 Serial No.

Nitrification Field: No Fields 1 Square Feet 1200* Linear Feet 400*

No Lines 4@100' Trench Width 3' Max Trench Bottom Depth 3' Gravel Depth NA

☒ New System ☐ Repair System Type: I, II, III, IV, V, VI

System Description: *PM → 25% Reduction

Repair System Description: Pressure → 16" PBBPS

Maintenance Agreement Required: ☐ Yes ☒ No

☒ House/Mod. Home No. Bedrooms 4

☐ Mobile Home No. Bathrooms 6

☐ Business No. Employees

☐ Other

☐ Slab ☐ Crawl Space ☒ Basement w/plumbing ☐ Basement wo/plumbing


Water Supply: ☒ Individual ☐ Public ☐ Community

Comments/Conditions: Surface Water Diversion required on R side of driveway. Front of house 45' minimum from R/W.


Comments/Conditions: 5 @ 90' x 3' w/ 6" stone cover

(1"=50')

INITIAL SITE SKETCH

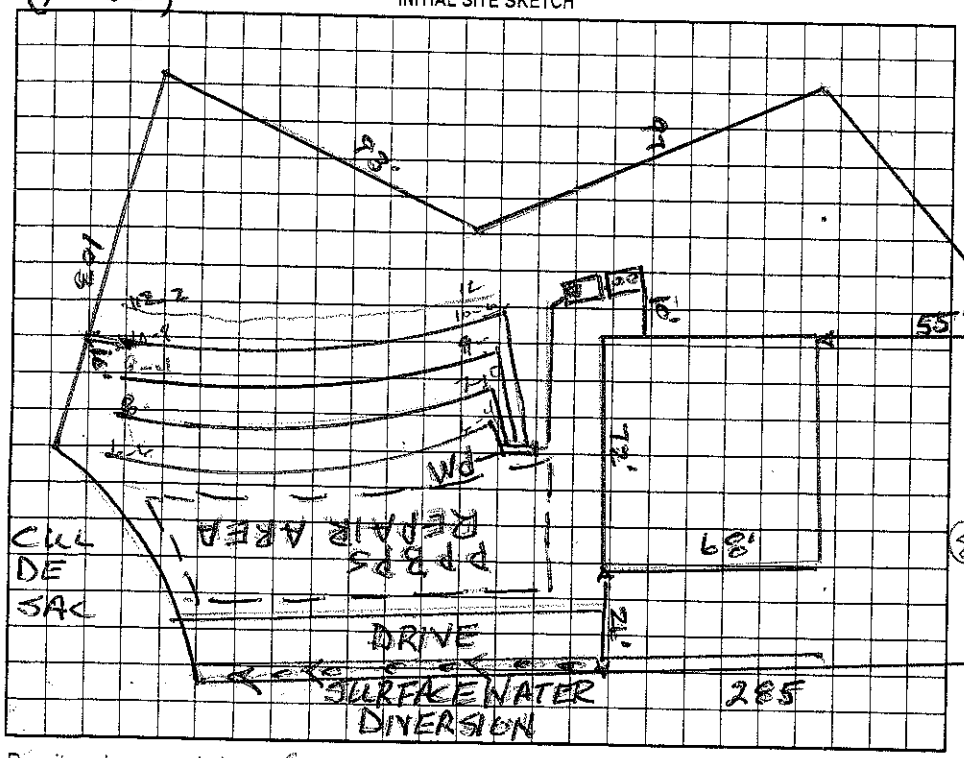

AS BUILT SKETCH

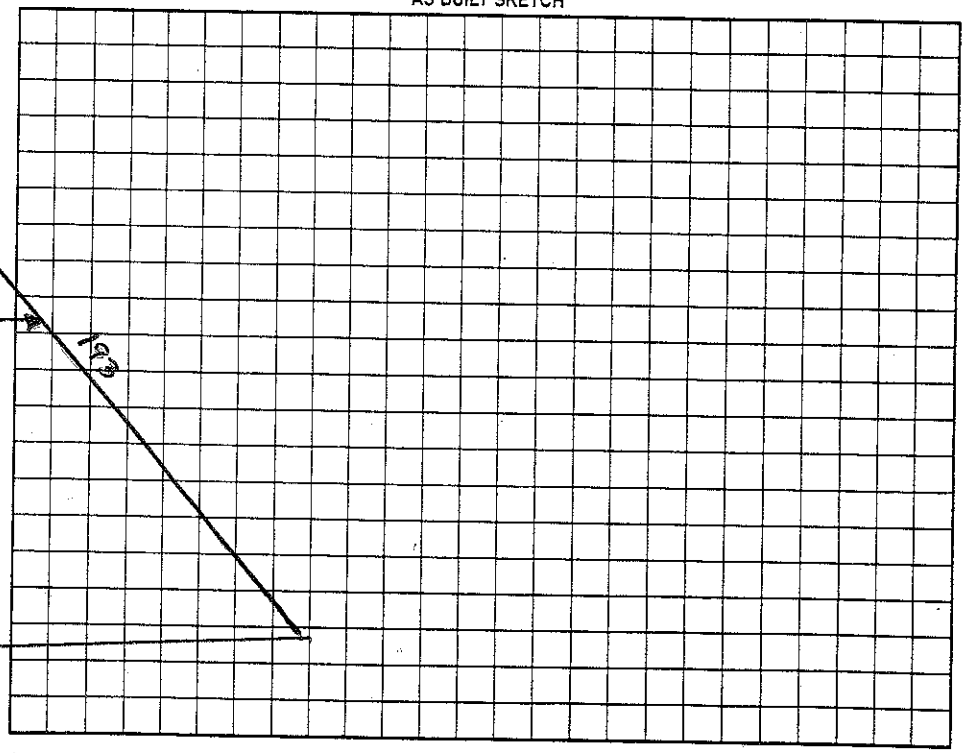

Permit can be suspended or revoked if any false information is supplied toward securing the permit/any unauthorized changes are made to the site/any unauthorized changes are made in the installation of the system. Improvement Permit with plat valid without expiration. Improvement Permit with site plan valid for sixty months. Authorization to Construct is valid for a period equal to that of Improvement Permit – not to exceed sixty months.

Signed: * Kate M Beal date 5/27/05 Installed by: CD Roseman

Improvement Permit by: Wesley Sparks R.S. date 5/4/05 Operation Permit by: Josh E Allen date 10/23/06

Authorization to Construct by: Wesley Sparks R.S. date 5/4/05 Existing System Inspection by: date

HEALTH DEPT. COPY: WHITE OWNER COPY (FINAL): YELLOW OWNER COPY (INITIAL): PINK