IREDELL COUNTY HEALTH DEPARTMENT

STATESVILLE 704-878-5305 MOORESVILLE 704-664-5281

IMPROVEMENT PERMIT / AUTHORIZATION TO CONSTRUCT / OPERATION PERMIT / EXISTING SYSTEM INSPECTION

PERMIT# 120380 PIN# 4628 97 6069.6 4628974118 DATE 6/19/07

OWNER OR APPLICANT Oscar Koehler PHONE: Business 704-309-0227 Home

ADDRESS 167 Maple View Dr. Troutman, NC 28166

LOCATION Perth N TL Fern Hill TR Fern Haven, 1st on (L)

SUBDIVISION Fern View BLOCK / SECTION LOT 6 LOT AREA +/- 1.3 AC SITE CLASS P3 DESIGN FLOW 480 L.T.A.R. .30 Original / .25 Repair

Septic Tank: 1000 Gallons; STB 312 Date 5/1/07

Pump Tank: 1000 Gallons; PT 27 Date 2/5/07

Pump Make: Model Serial No.

Nitrification Field: No Lines 4 @ 100 Square Feet 1200 Linear Feet 400

Trench Width 3' Max Trench Bottom Depth 3' Gravel Depth N/A ☐ Gravity ☒ Pressure

☒ New System ☐ Repair ☐ Expansion System Type: I II III IV V VI

System Description: 4 bed Manifold - 2500 Reduction

Repair System Description: PPBPS - Pressure

Maintenance Agreement Required: ☐ Yes ☒ No / NITIAMS

☒ House/Mod. Home No. Bedrooms 4

☐ Mobile Home No. Persons

☐ Business No. Employees

☐ Other


Water Supply: ☒ Individual ☐ Public ☐ Community

☐ Slab ☒ Crawl Space ☐ Basement w/plumbing ☐ Basement wo/plumbing


Comments:/Conditions: Repair Area 37' 160ft3

Comments:/Conditions: Shift the Transmitter Line to Tank, Drain Field, Perm

INITIAL SITE SKETCH

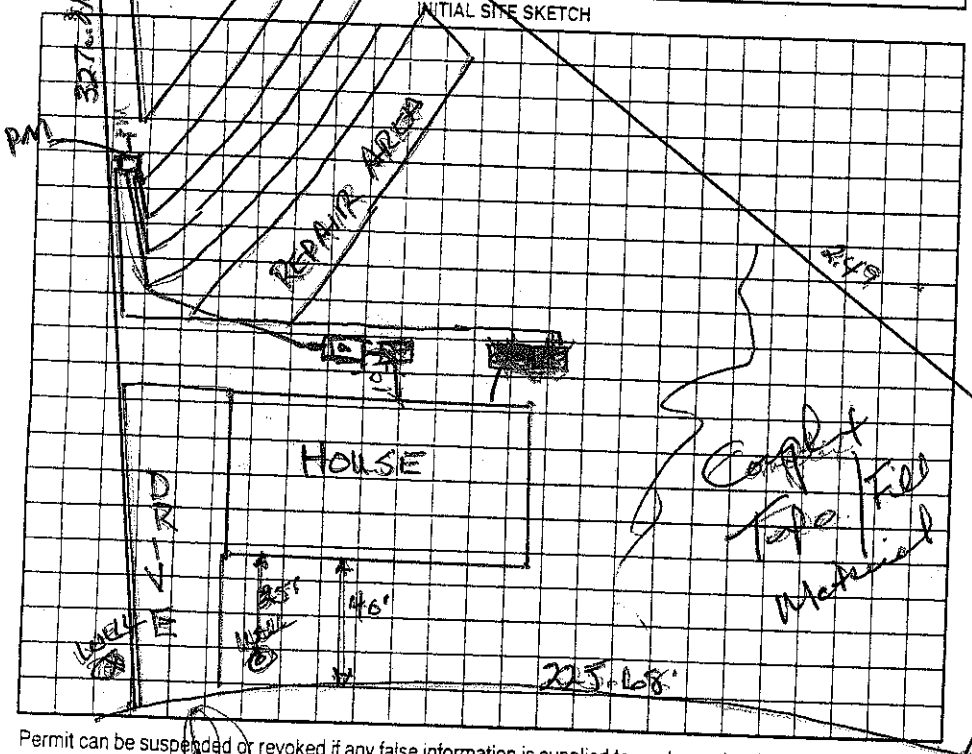

AS BUILT SKETCH

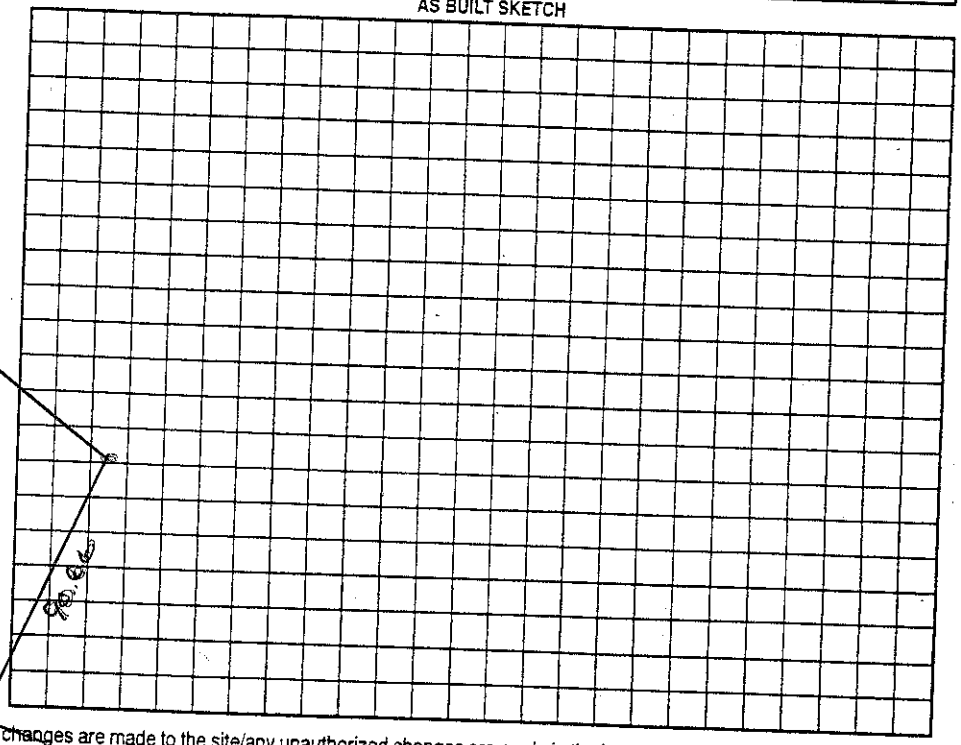

Permit can be suspended or revoked if any false information is supplied toward securing the permit/any unauthorized changes are made to the site/any unauthorized changes are made in the installation of the system. Improvement Permit with plat valid without expiration ☐ Improvement Permit with site plan valid for sixty months ☐ Authorization to Construct is valid for a period equal to that of Improvement Permit – not to exceed sixty months.

Signed: X

Improvement Permit by: Wesley Sparks RS date 6/20/07

Authorization to Construct by: Wesley Sparks RS date 6/19/07

Installed by: Comfort Dynamics

Operation Permit by: Wesley Sparks RS. date 11/14/07

Existing System Inspection by: date

HEALTH DEPT. COPY: WHITE OWNER COPY (FINAL): YELLOW OWNER COPY (INITIAL): PINK