$375

IREDELL COUNTY HEALTH DEPARTMENT

STATESVILLE 704-878-5305 MOORESVILLE 704-664-5281

IMPROVEMENT PERMIT / AUTHORIZATION TO CONSTRUCT / OPERATION PERMIT / EXISTING SYSTEM INSPECTION

PERMIT# 108486 PIN# 4628-97-8973 DATE 9/9/02

OWNER OR CONTRACTOR Lippard Bldg. Inc PHONE: Business 704-528-4608 Home

ADDRESS 612 Hoover Rd. Troutman NC 28166

LOCATION Perth, TL Fein Hill, TR St. Charles at end on Lt. 149 ST CHARLES LN

SUBDIVISION CLFJ BLOCK / SECTION 15 LOT 112 LOT AREA 0.67 AC SITE CLASS. PS DESIGN FLOW 480 L.T.A.R. ~.3

Septic Tank: 1000 Gallons; STB 1012 Date 6/13/04

Pump Tank: 1000 Gallons; PT 17 Date 6/9/04

Pump Make: Myers Model ME50S11 Serial No.

Nitrification Field: No Fields 1 Square Feet 795 Linear Feet 265

No Lines 5 Trench Width 24" Max Trench Bottom Depth 36" Gravel Depth —

☒ New System ☐ Repair System Type: I, II, III, IV, V, VI

System Description: LP Panel Block

Repair System Description: Deeded prior to 1783

Maintenance Agreement Required: ☒ Yes ☐ No

☒ House/Mod. Home ☐ Mobile Home ☐ Business ☐ Other

No. Bedrooms 4 No. Bathrooms 5 No. Employees

Water Supply: ☒ Individual ☐ Public ☐ Community

☐ Slab ☒ Crawl Space ☒ Basement w/plumbing ☒ Basement wo/plumbing


Comments:/Conditions:

* Small depressions to be Filled in with soil
Solid pipe through depression to join Panel Lines


Comments:/Conditions: Partial

Lot could have Partial Repair if Well were properly Abandoned

INITIAL SITE SKETCH

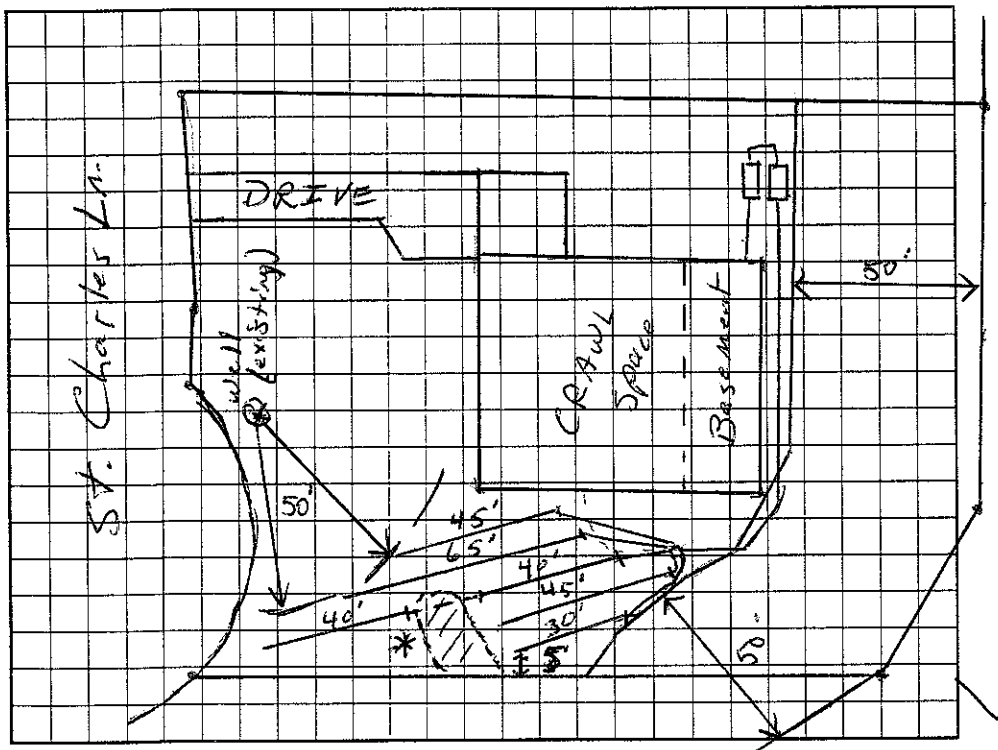

AS BUILT SKETCH

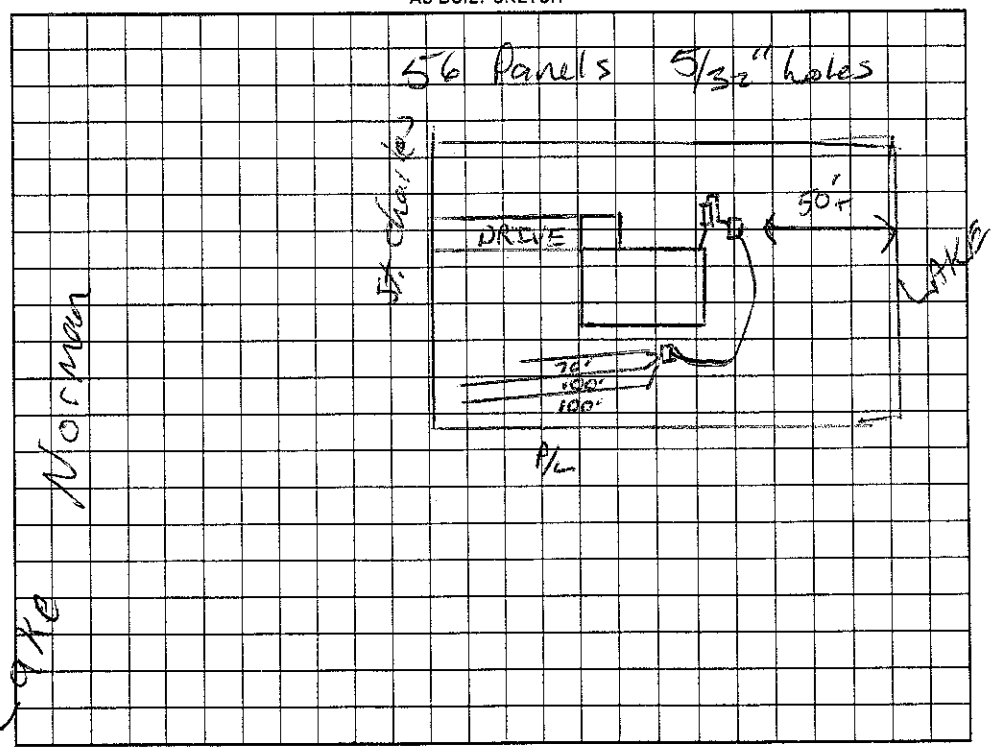

Permit can be suspended or revoked if any false information is supplied toward securing the permit/any unauthorized changes are made to the site/any unauthorized changes are made in the installation of the system. Improvement Permit with plat valid without expiration. Improvement Permit with site plan valid for sixty months. Authorization to Construct is valid for a period equal to that of Improvement Permit – not to exceed sixty months.

Signed: [signature] date 9-12-02 Installed by: Craig Thompson

Improvement Permit by: [signature] RS date 9/9/02 Operation Permit by: [signature] RS date 3/22/05

Authorization to Construct by: [signature] RS date 9/9/02 Existing System Inspection by: date

HEALTH DEPT. COPY: WHITE OWNER COPY (FINAL): YELLOW OWNER COPY (INITIAL): PINK