IREDELL COUNTY HEALTH DEPARTMENT

STATESVILLE 704-878-5305 375.00 Pg. 2 MOORESVILLE 704-664-5281

IMPROVEMENT PERMIT / AUTHORIZATION TO CONSTRUCT / OPERATION PERMIT / EXISTING SYSTEM INSPECTION

PERMIT# 094084 PIN# 4628 98 7031 DATE 4/16/01

OWNER OR CONTRACTOR Mary Sotile PHONE: Business Home 704-528-4608

ADDRESS 2725 Country Club Rd. Winston Salem, NC. 1555 St. Charles Ln.

LOCATION Perth N TL Fern Hill R St Charles, at the end of R cul de sac

SUBDIVISION CL+T BLOCK / SECTION 15 LOT 113 LOT AREA .69 SITE CLASS. PS DESIGN FLOW 360 L.T.A.R. .3

Septic Tank: 1000 Gallons: STB 1012 Date 3/4/03
Pump Tank: 1000 Gallons: PT 17 Date 7/9/03
Pump Make: MYERS Model SRM-4RC1 Serial No. 07-03
Nitrification Field: No Fields 1 Square Feet 420 Linear Feet 210
No Lines 3@70' Trench Width 2' Max Trench Bottom Depth 3' Gravel Depth No

[X] New System [ ] Repair System Type: I, II, III, IV, V, VI
System Description: Bottom Load 16" PABRS
Repair System Description: < 1983
Maintenance Agreement Required: [X] Yes [ ] No

[X] House/Mod. Home No. Bedrooms 3
[ ] Mobile Home No. Bathrooms 3
[ ] Business No. Employees
[ ] Other LN


[ ] Slab [X] Crawl Space [ ] Basement w/plumbing [ ] Basement wo/plumbing

Water Supply: [X] Individual [ ] Public [ ] Community


Comments:/Conditions:
Properly Abandon old well before attempting to install Drainfield.

Comments:/Conditions:

(1" = 30') INITIAL SITE SKETCH

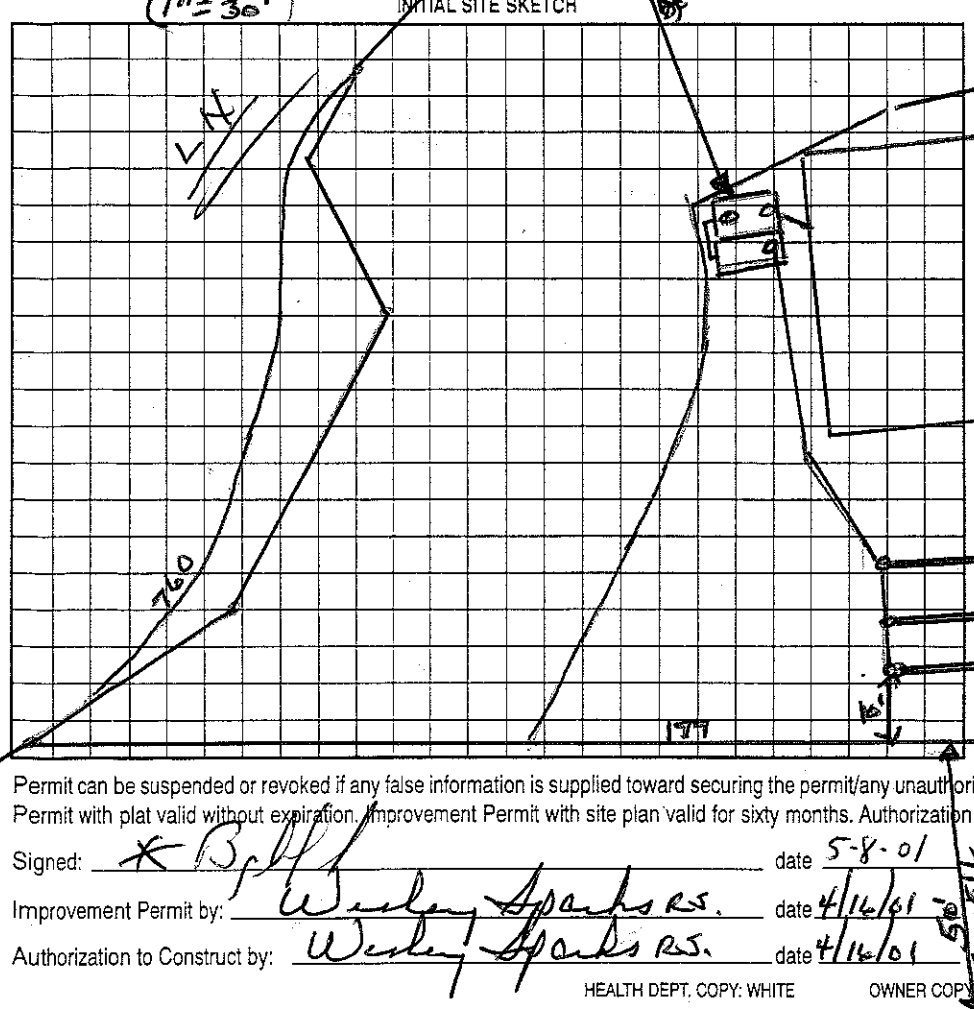

AS BUILT SKETCH

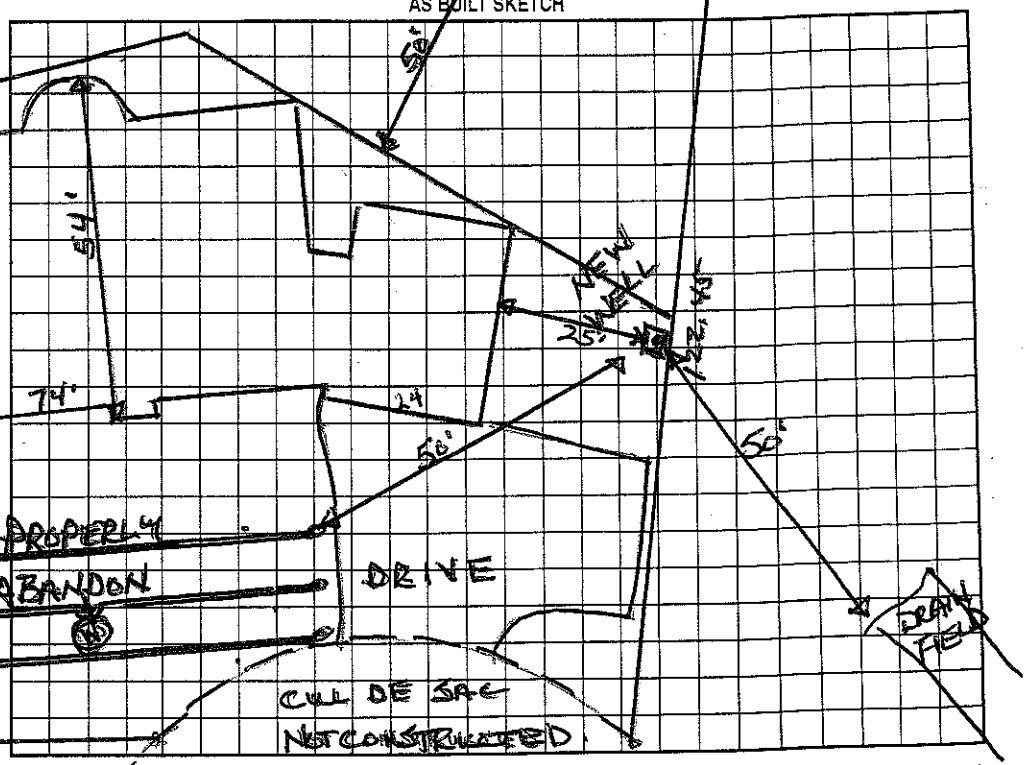

Permit can be suspended or revoked if any false information is supplied toward securing the permit/any unauthorized changes are made to the site/any unauthorized changes are made in the installation of the system. Improvement Permit with plat valid without expiration. Improvement Permit with site plan valid for sixty months. Authorization to Construct is valid for a period equal to that of Improvement Permit – not to exceed sixty months.

Signed: X [signature] date 5-8-01

Improvement Permit by: Wesley Sparks RS. date 4/16/01

Authorization to Construct by: Wesley Sparks RS. date 4/16/01

Installed by: ST CHARLES Craig Thompson

Operation Permit by: Wesley Sparks RS. date 10/21/

Existing System Inspection by:

HEALTH DEPT. COPY: WHITE OWNER COPY (FINAL): YELLOW OWNER COPY (INITIAL): PINK