IREDELL COUNTY HEALTH DEPARTMENT

Authorization To Construct 4628989945 4 of

STATESVILLE 704-878-5305 MOORESVILLE 704-664-5281

IMPROVEMENT PERMIT / ~~CERTIFICATE OF COMPLETION~~ / OPERATION PERMIT / EXISTING SYSTEM INSPECTION

PROPERTY DESCRIPTION NO. REPAIR DATE 8/18/97 TAX MAP NO. N/A Watershed: [X] Yes [ ] No

OWNER OR CONTRACTOR Bob COX PHONE: Business _____ Home 910-725

ADDRESS 154 Fairburn Dr. Mooresville, NC. 28115

LOCATION Fern Hill Rd (L) off Perth Rd. 2.8 miles TR on Fairburn Dr. to 5th drive on (R)

SUBDIVISION _____ BLOCK / SECTION _____ LOT _____ LOT AREA _____ SITE CLASS. _____ DESIGN FLOW 360 L.T.A.R. _____

Septic Tank: 1500 Gallons; STB 1014 Date 4/22/97
Pump Tank: _____ Gallons; PT _____ Date _____
Pump Make: _____ Model _____ Serial No. _____
Nitrification Field: No Fields ____ Square Feet _____ Linear Feet _____
No Lines _____ Trench Width _____ Max Trench Bottom Depth _____ Gravel Depth _____

[ ] New System [X] Repair System Type: I (II) III, IV, V, VI
System Description: Bed 20' x 25'
Repair System Description: _____
Maintenance Agreement Required: [ ] Yes [ ] No


[X] House/Mod. Home No. Bedrooms 3
[ ] Mobile Home No. Bathrooms 2
[ ] Business No. Employees ____
[ ] Other _____
[ ] Slab [ ] Crawl Space [ ] Basement w/plumbing [ ] Basement wo/plumbing

Water Supply:
[X] Individual
[ ] Community
[ ] Public

Comments:

Comments:

INITIAL SITE SKETCH

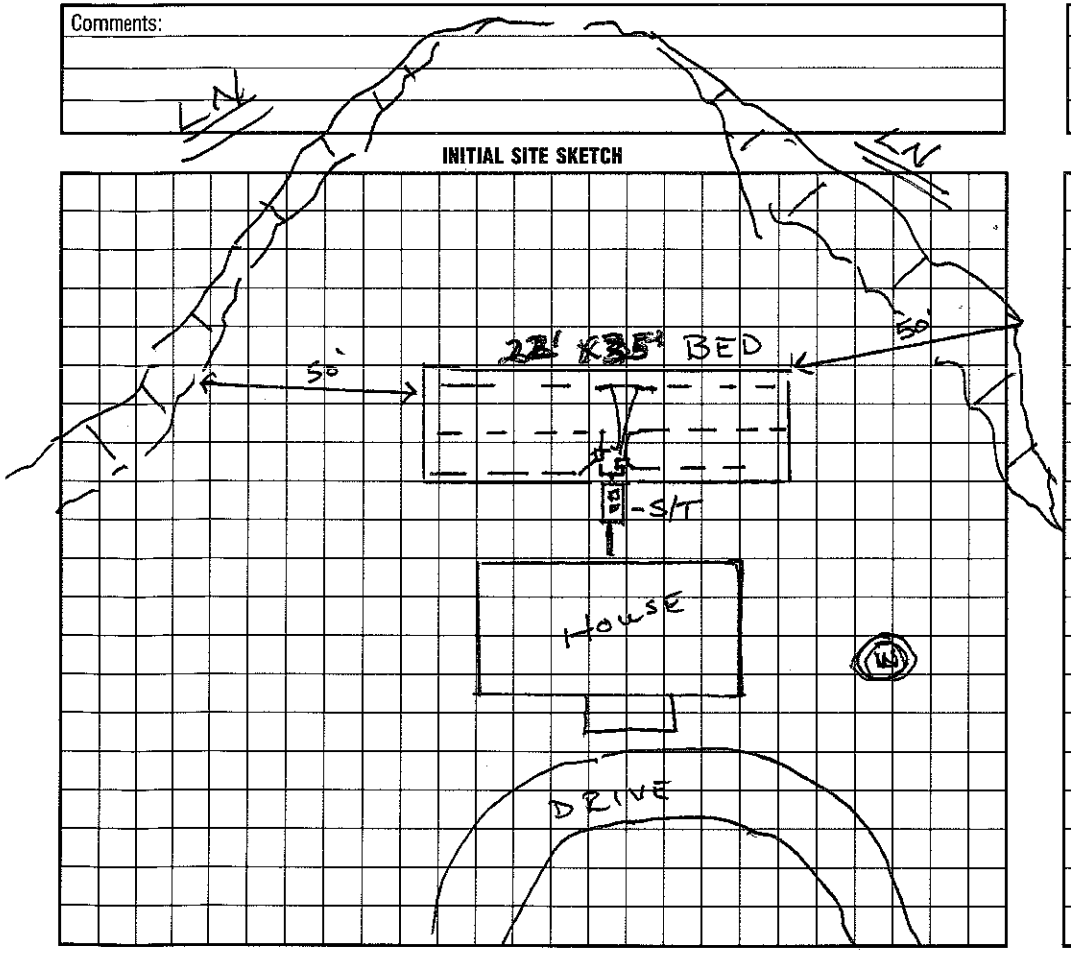

AS BUILT SKETCH

I understand that this permit can be suspended or revoked if any false information is supplied toward securing the permit/any unauthorized changes are made to the site/any unauthorized changes are made in the installation of the system. Improvement Permit is valid for 60 months from date of issuance.

Signed: * Robert M. Cox

Improvement Permit by: Wesley Sparks RS. date 8/18/97

~~Existing System Inspection by:~~ Wesley Sparks RS. date 8/18/97

Installed by: Wayne County

Certificate of Completion by: Wesley Sparks R.S. date 10/7/97

Operation Permit by: Wesley Sparks RS date 10/7/97

HEALTH DEPT. COPY: WHITE INSPECTION COPY (FINAL): GREEN OWNER COPY (FINAL): YELLOW INSPECTION COPY (INITIAL): PINK OWNER COPY (INITIAL): GOLD