IREDELL COUNTY HEALTH DEPARTMENT

Statesville Phone TR 3-7271 Mooresville Phone NO 3-1271

PERMIT TO INSTALL SEPTIC TANK

Permit NO. 105 Permit Date 8 - 17 19 72

Owner Phillips Enterprises (Bob Phillips) Address

Installed By Sam Mitchell Address Troutman N.C.


Location of Property Turn on S. Main St. at Troutman T.L. at Shiloh Baptist Ch. T.R. at 1st Presbyterian Church T.L. approx. 1/4 mile on R. 1st road on R. house on R.

Tank		Capacity		Length of Lines		Fixtures	
Block	( )	1000	(✓)	225'	(✓)	No. of Baths	(2)
Precast	(✓)	1250	( )	250'	( )	Dishwasher	( )
		1500	( )	Other		Garbage Grdr.	( )
		Other				Other	

NOTIFY HEALTH DEPARTMENT AT LEAST EIGHT HOURS BEFORE TANK IS TO BE INSPECTED.

Final Inspection 8-24 1972 Approved (✓) Disapproved ( )

Remarks Well over 200'

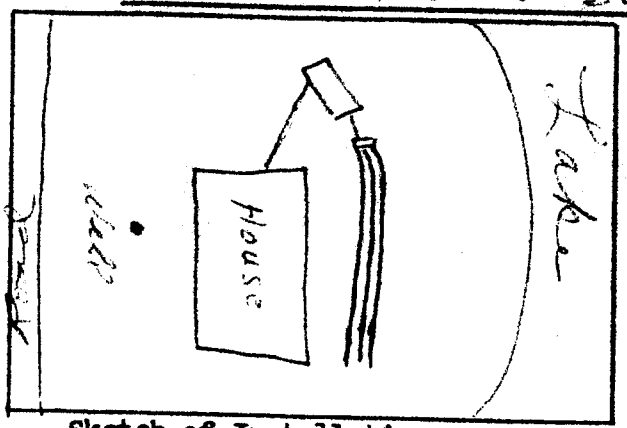

Sketch of Installation

E. A. Stevenson

Sanitarian