IREDELL COUNTY HEALTH DEPARTMENT

Statesville Phone TR 3-7271 Mooresville Phone NO 3-1271

PERMIT TO INSTALL SEPTIC TANK

Permit Date May 28 1966

Permit NO. _____

Owner Statesville Brick Address Lake Norman

Installed By S & D Address Statesville N.C.


Location of Property ox Lun-Let Point, Lake Norman

Tank		Capacity		Length of Lines		Fixtures	
Block	(✓)	1000	(✓)	225'	(✓)	No. of Baths	( )
Precast	( )	1250	( )	250'	( )	Dishwasher	( )
		1500	( )	Other _____		Garbage Grdr.	( )
		Other _____				Other _____	

NOTIFY HEALTH DEPARTMENT AT LEAST EIGHT HOURS BEFORE TANK IS TO BE INSPECTED.

Final Inspection May 28 1966 Approved (✓) Disapproved ( )

Remarks _____

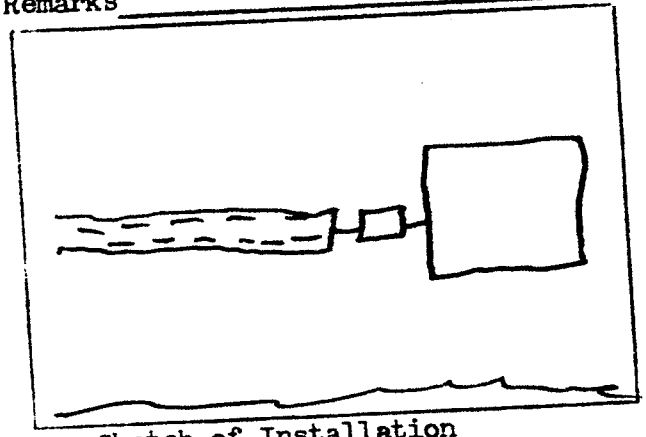

Sketch of Installation

Robert W Johnson RS
Sanitarian