IREDELL COUNTY HEALTH DEPARTMENT

Statesville Phone TR 3-7271 Mooresville Phone NO 3-1271

PERMIT TO INSTALL SEPTIC TANK

Permit NO. _____ Permit Date May 28 1966

Owner Statesville Brick Co. Address Statesville N.C.

Installed By D + S Address Statesville N.C.

Location of Property Lake Norman (on Sun Set Point)


Tank		Capacity		Length of Lines		Fixtures	
Block	(✓)	1000	(✓)	225'	(✓)	No. of Baths	( )
Precast	( )	1250	( )	250'	( )	Dishwasher	( )
		1500	( )	Other _____		Garbage Grdr.	( )
		Other _____				Other _____	

NOTIFY HEALTH DEPARTMENT AT LEAST EIGHT HOURS BEFORE TANK IS TO BE INSPECTED.

Final Inspection May 28 1966 Approved (✓) Disapproved ( )

Remarks _____

Gold

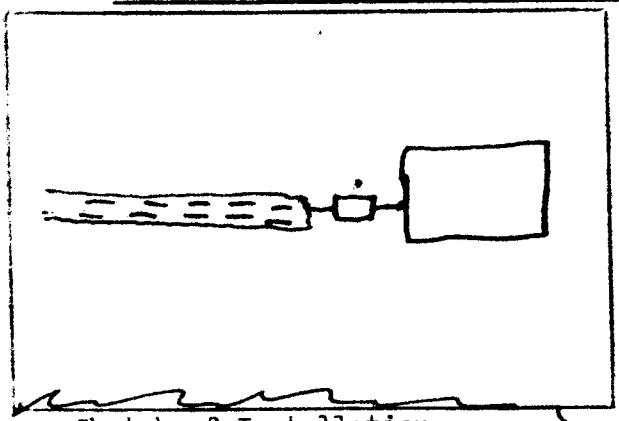

Sketch of Installation

Billie W Johnson RS

Sanitarian