IREDELL COUNTY HEALTH DEPARTMENT

Statesville Phone TR 3-7271 Mooresville Phone NO 3-1271

PERMIT TO INSTALL SEPTIC TANK

Permit NO. _____ Permit Date 9-16 19 67

Owner Fred Sloan Address City

Installed By C Hoke Address R7


Location of Property beside Statesville Brick Lodge at Sunset Point. Left Paved Rd before State Park R- end of Pavement - Left at sign - end of Rd.

Tank		Capacity		Length of Lines		Fixtures	
Block	( )	1000	(✓)	225'	( )	No. of Baths	( )
Precast	(✓)	1250	( )	250'	( )	Dishwasher	( )
		1500	( )	Other 245'		Garbage Grdr.	( )
		Other _____				Other Wt Red Cabin	

NOTIFY HEALTH DEPARTMENT AT LEAST EIGHT HOURS BEFORE TANK IS TO BE INSPECTED.

Final Inspection _____ 19___ Approved ( ) Disapproved ( )

Remarks well 100'

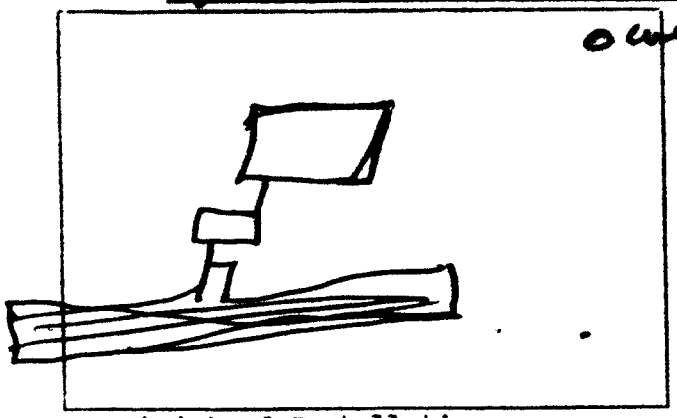

Sketch of Installation

_____

Sanitarian