I, Dennis Freeman, know that end of septic lines are 25' from the foundation of the building.

Dennis W. Freeman

# IREDELL COUNTY HEALTH DEPARTMENT

STATESVILLE 704-878-5305 MOORESVILLE 704-664-5281

## IMPROVEMENT PERMIT / AUTHORIZATION TO CONSTRUCT / OPERATION PERMIT / EXISTING SYSTEM INSPECTION

PERMIT# 093540 PIN# 4629428292 DATE 8-30-99

OWNER OR CONTRACTOR Dennis Freeman PHONE: Business Home 336-765-7197

ADDRESS 4501 Country Club Rd Winston-Salem NC

LOCATION State Park Rd TL Morrison Farm TR Hpn TL Windward TR Tinker Near end on (L)

SUBDIVISION BLOCK / SECTION 17 LOT 133 LOT AREA 1.05 SITE CLASS DESIGN FLOW L.T.A.R.

Septic Tank: 1250 Ex. Gallons; STB Date
Pump Tank: Gallons; PT Date
Pump Make: Model Serial No.
Nitrification Field: No Fields Square Feet Linear Feet 250
No Lines 3 Bed Trench Width Max Trench Bottom Depth Gravel Depth

☐ New System ☐ Repair System Type: I. II. III. IV. V. VI
System Description:
Repair System Description:
Maintenance Agreement Required: ☐ Yes ☐ No


☒ House/Mod. Home No. Bedrooms 2
☐ Mobile Home No. Bathrooms 2
☐ Business No Employees
☐ Other
☐ Slab ☐ Crawl Space ☒ Basement w/plumbing ☐ Basement wo/plumbing

Water Supply: ☒ Individual ☐ Public ☐ Community


Comments/Conditions:

Comments /Conditions: Original Permit sized for 2 Bedrooms. Existing System Check - System Tank is deep - Recommend pumping Tank

INITIAL SITE SKETCH

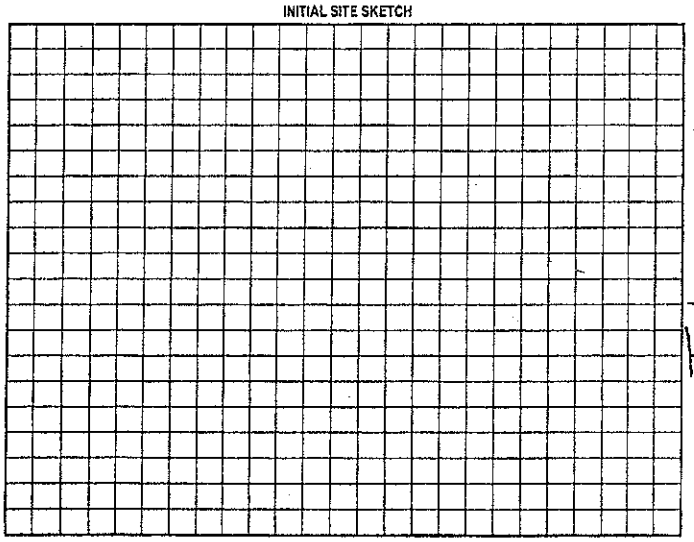

AS BUILT SKETCH Keep System from Keep Basement 15 Ft from system. Keep Footers 5Ft

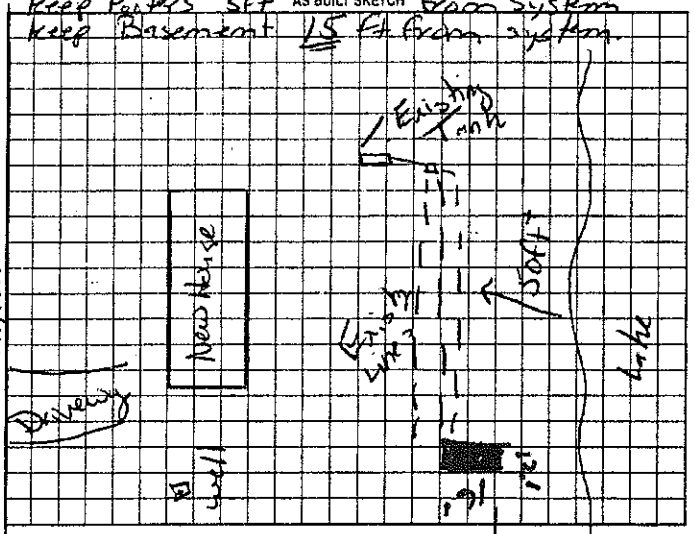


Permit can be suspended or revoked if any false information is supplied toward securing the permit/any unauthorized changes are made to the site/any unauthorized changes are made in the installation of the system. Improvement Permit with plat valid without expiration. Improvement Permit with site plan valid for sixty months. Authorization to Construct is valid for a period equal to that of Improvement Permit – not to exceed sixty months.

Signed: date Installed by:

Improvement Permit by: date Operation Permit by: date

Authorization to Construct by: date Existing System Inspection by: MAC Offers date 8-30-99.

HEALTH DEPT COPY WHITE OWNER COPY (FINAL) YELLOW OWNER COPY (FINAL) PINK

Location of the proposed 12x16' storage building on addition does not appear to impact the existing on-site septic system.**NOTE: Skids 75' from water

REHS

Date: 8-5-11

ICHD-Environmental Health Division