THIS PERMIT EXPIRES

IREDELL COUNTY HEALTH DEPARTMENT

STATESVILLE 704-878-5305 MOORESVILLE 704-664-5201

IMPROVEMENT PERMIT / AUTHORIZATION TO CONSTRUCT / OPERATION PERMIT / EXISTING SYSTEM INSPECTION

DATE 3-16-04

PERMIT# 086080 11994 PIN# 4639-73-4457 4629-93-2713 PHONE: Business _____ Home 704 660-3319

OWNER OR CONTRACTOR ROBERT SAIN

ADDRESS 1164 KISKADEE DR MOORESVILLE, NC 28117

LOCATION 21 SOUTH (E) PORTH, (E) STATE PARK (L) MORRISON FARM (R) APPX .5 MI IN 1ST DE SAC

SUBDIVISION HAWKS BAY BLOCK / SECTION _____ LOT 24 24A LOT AREA 60,044 +24,325 SITE CLASS PS DESIGN FLOW 420. L.T.A.R. .5

Septic Tank: 1000 Gallons: STB 3/2 Date 1-12-04

Pump Tank: 1000 Gallons: PT 27 Date 2-31-04?

Pump Make: GOULDS Model WE07E1HD Serial No 5059770?

Nitrification Field: No Fields 1 Square Feet 1616.00' Linear Feet 270'

No Lines 4 Trench Width 24" Max Trench Bottom Depth 36" Gravel Depth N/A

☒ New System ☐ Repair System Type: I, II, III, (IV) V, VI

System Description: LP PAVEL BASIC

Repair System Description: LP/PM INNOVATIVE

Maintenance Agreement Required: ☒ Yes ☐ No ONSITE/AIR

☒ House/Mod. Home ☐ Mobile Home ☐ Business ☐ Other

No. Bedrooms 4 No. Bathrooms 4 No. Employees _____


☐ Slab ☐ Crawl Space ☒ Basement w/plumbing ☐ Basement wo/plumbing

Water Supply: ☒ Individual ☐ Public ☐ Community


Comments/Conditions: (1) CALL PRIOR TO ANY EXCAVATION FOR CONSULTATIVE VISIT ABOUT GRADING + SETBACKS (2) CALL PRIOR TO INSTALLATION OF SYSTEM FOR RAMP SIZING + SPECS IF NECESSARY (3) DO NOT CUT 319.99'

Comments/Conditions: BASEMENT ACCESSIBLE, MAINTAIN PROPER FALL TO THE TANKS + KEEP THEM ABOVE THE 50' SETBACK (4) THE PERMIT WAS REDRAWN OFF PREVIOUSLY ISSUED PERMIT DATED DEC. 20 1999. ONLY CHANGES THAT WERE MADE WAS: ST + PT LOCATIONS, WELL

INITIAL SITE SKETCH

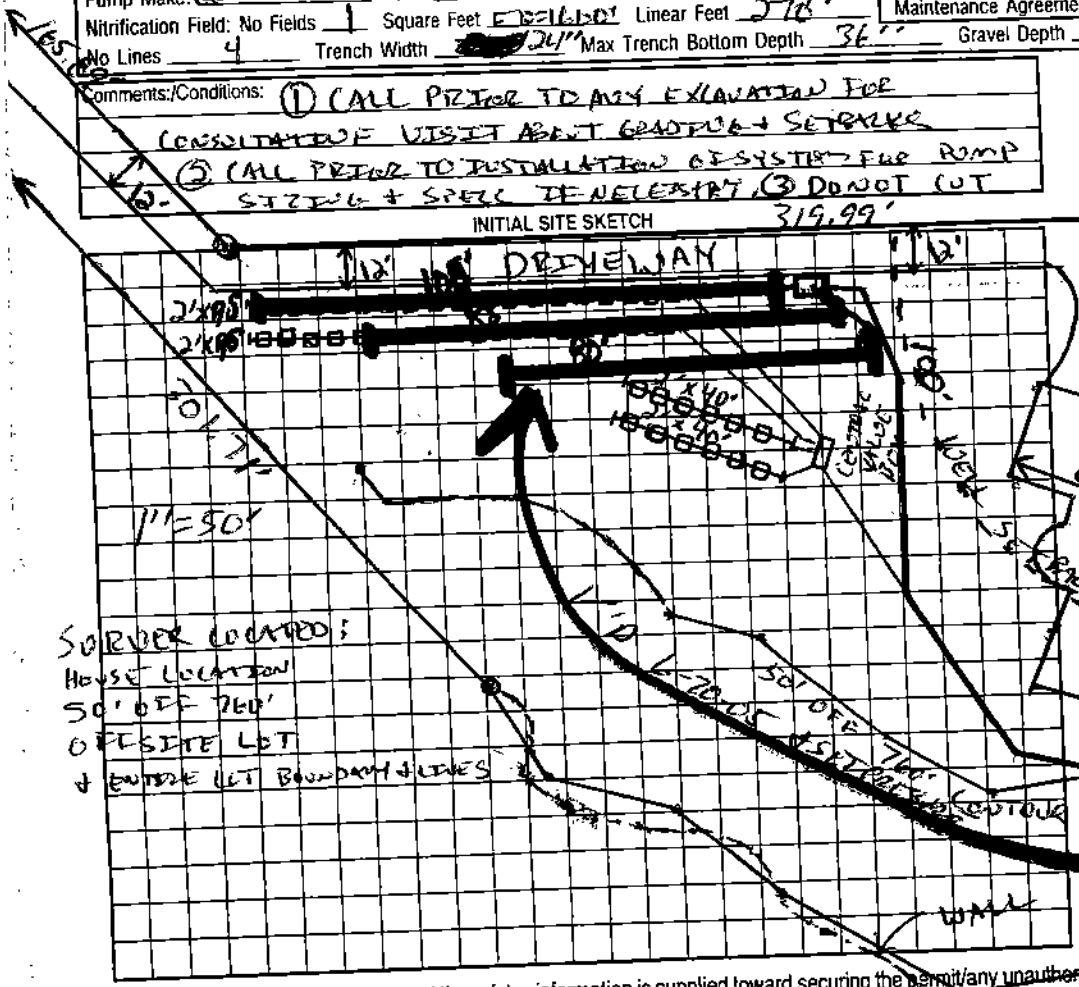

AS BUILT SKETCH + HOUSE SIZE.

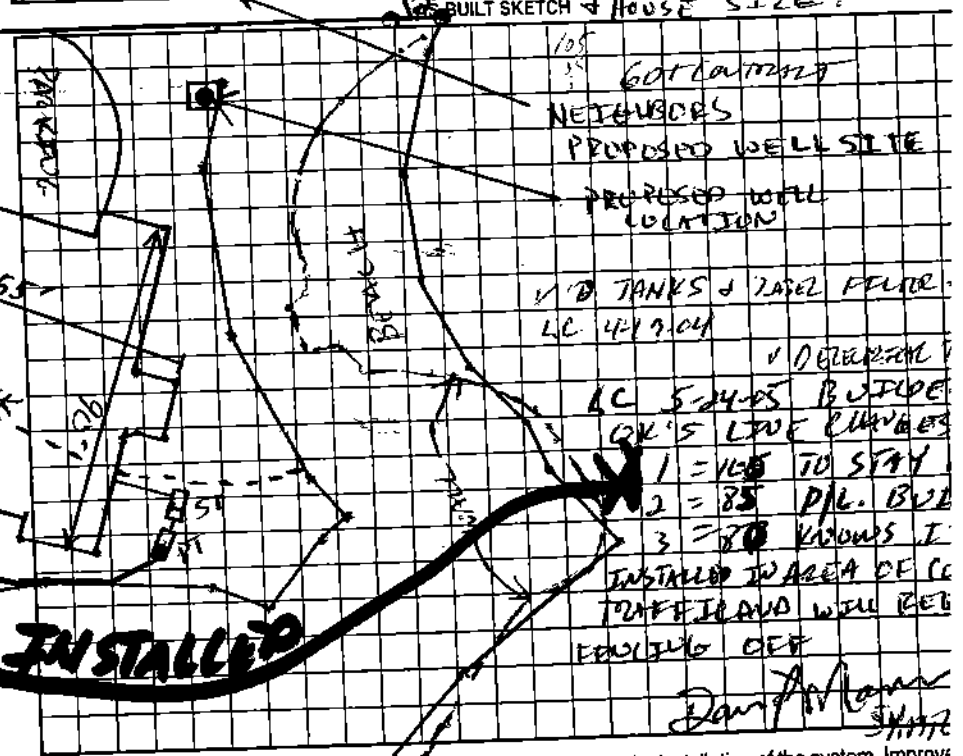

Permit can be suspended or revoked if any false information is supplied toward securing the permit/any unauthorized changes are made to the site/any unauthorized changes are made in the installation of the system. Improve

Permit with plat valid without expiration. Improvement Permit with site plan valid for sixty months. ~~Authorization to Construct is valid for a period equal to that of Improvement Permit~~ – not to exceed sixty months.

Signed: _____ date 3-17-04 Installed by: ORBISON 7-22-2004

Improvement Permit by: _____ date 3-16-04 Operation Permit by: _____ date 7-22-

Authorization to Construct by: _____ date 3-16-04 Existing System Inspection by: _____ date _____

HEALTH DEPT. COPY: WHITE OWNER COPY (FINAL): YELLOW OWNER COPY (INITIAL): PINK