IREDELL COUNTY HEALTH DEPARTMENT

STATESVILLE 704-878-5305 MOORESVILLE 704-664-5281

IMPROVEMENT PERMIT / AUTHORIZATION TO CONSTRUCT / OPERATION PERMIT / EXISTING SYSTEM INSPECTION

PERMIT# ~~086-676~~ 117993 PIN# ~~4638734457 (Lot)~~ 4629 43 6857 DATE Jan 13, 2000

OWNER OR CONTRACTOR ~~Crescent Resources Inc.~~ Timothy Hawes PHONE: Business _____ Home _____

ADDRESS P.O. Box 1003, Charlotte

LOCATION State Park Rd. TL Morrison Farm Rd. TR April Rd. on Right

SUBDIVISION Hawkes Bay BLOCK / SECTION _____ LOT 22, 22A LOT AREA 28,241 + 27,638 ft² SITE CLASS. PS SFE DESIGN FLOW 480 gpd L.T.A.R. .3 SFE

Septic Tank: 1000 Gallons; STB 312 Date 5-24-04
Pump Tank: 1000 Gallons; PT 27 Date 5-24-04
Pump Make: Goulds Model WE1512H Serial No SD5071204
Nitrification Field: No Fields ___ Square Feet 1200+ Linear Feet 400+
No Lines 5@80+ Trench Width 36" Max Trench Bottom Depth 36"


☑ New System ☐ Repair System Type: I, II, III, IV, V, VI
System Description: PM - Innovative - 25% Reduction
Repair System Description: LP Panel Block
Maintenance Agreement Required: ☐ Yes ☑ No initially
Gravel Depth NA

☑ House/Mod. Home No. Bedrooms 4
☐ Mobile Home No. Bathrooms 4
☐ Business No. Employees ___
☐ Other _____
☐ Slab ☐ Crawl Space ☑ Basement w/plumbing ☐ Basement wo/plumbing

Water Supply: ☑ Individual ☐ Public ☐ Community

Comments:/Conditions: ONE INSPECTION PORT PER LATERAL

INITIAL SITE SKETCH

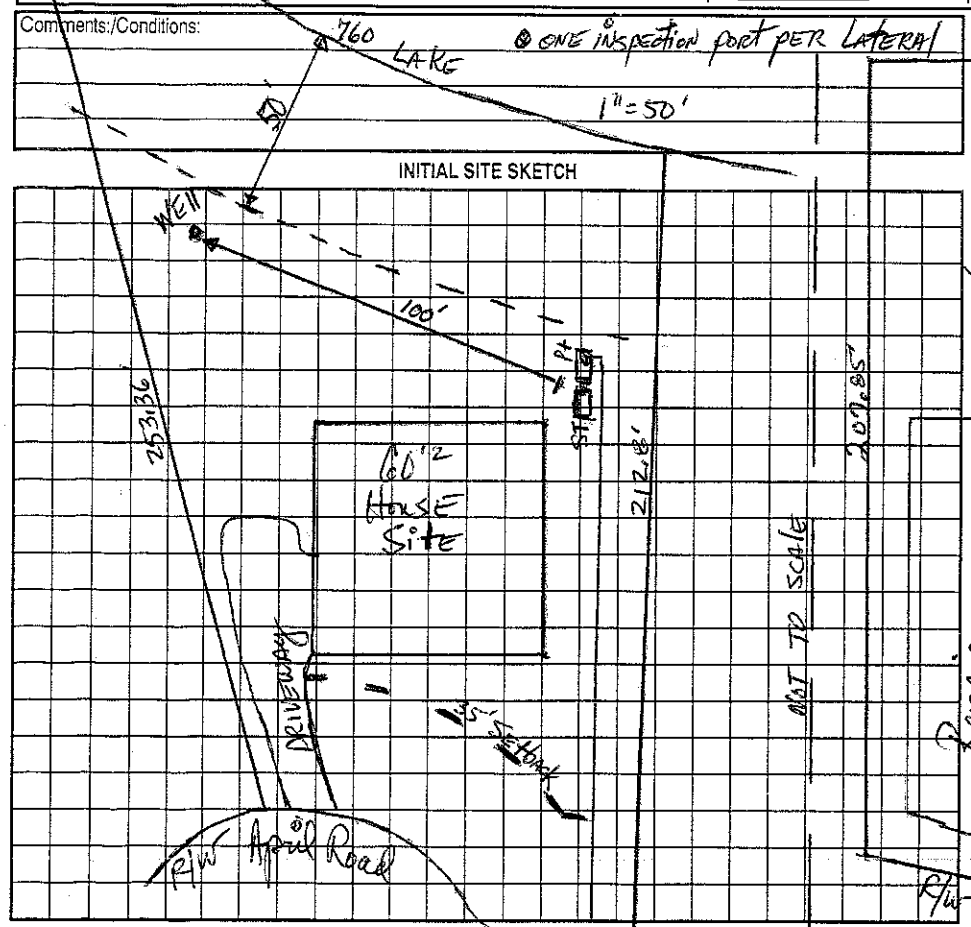


Comments:/Conditions: REVIEWED PLANS ON 7-31-03. MET CONTRACTOR, EXPLAINED TO HIM SETBACKS MUST BE MAINTAINED EVEN TO WELLS, LC 7-31-03

AS BUILT SKETCH SEE ATTACHED PLANS. APPROVED MOVING THE TANKS AS ATTACHED PLANS SHOW AS LONG AS SETBACKS CAN BE MAINTAINED, LC 7-31-03

V'D LINES 6-25-04. LINES 10' + OFF FLAGGED P/L

6-30-04 RINSED FIELD LINES & MANIFOLD & PERC'D

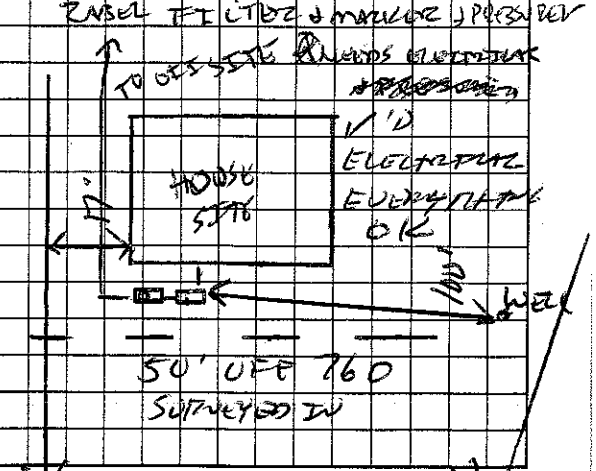

Permit can be suspended or revoked if any false information is supplied toward securing the permit/any unauthorized changes are made to the site/any unauthorized changes are made in the installation of the system. Improvement Permit with plat valid without expiration. Improvement Permit with site plan valid for sixty months. Authorization to Construct is valid for a period equal to that of Improvement Permit – not to exceed sixty months.

Signed: _____ date 1-14-06 Installed by: F. J. ERVIN

Improvement Permit by: _____, RS date 1-13-2000 Operation Permit by: _____ date 1-6-05

Authorization to Construct by: _____ date 7-31-03 Existing System Inspection by: _____ date _____

HEALTH DEPT. COPY: WHITE OWNER COPY (FINAL): YELLOW OWNER COPY (INITIAL): PINK