Owner: Dennis Forkin

IREDELL COUNTY HEALTH DEPARTMENT

Statesville Office (704) 878-5305 Mooresville Office (704) 660-3625 PERMIT # 2/24/16

IMPROVEMENT PERMIT / AUTHORIZATION TO CONSTRUCT / OPERATION PERMIT / EXISTING SYSTEM

PIN # 4629-43-7166.000

APPLICANT: ~~Harry Kimmis~~ Lakeshore Holdings APPLICANT ADDRESS: Po Box 951 Statesville NC 28687

SITE ADDRESS: 112 Nautilus Court, Troutman NC PHONE: 704-252-0252 ALT. PHONE:

SITE DIRECTIONS: Perth To State Park, TL Morrison Farm, TR Agnes, TL Nautilus

SUBDIVISION: Hawkes Bay SECTION: LOT # 29 LOT AREA: 1.074 Acre DESIGN FLOW: 480 GPD L.T.A.R.: .3


Septic Tank	1000	(gal)	STB	760	Date	5-10	☒ New System	☐ Repair	☐ Expansion	System Type: I II III (IV) V VI	
Pump Tank	1000	(gal)	PT	363	Date	6-27	System Description:	LP-PPTSPS			
Pump Make	Zoeller	Model	N153		Serial #		Repair System Description:	LP-PPTSPS			
# Nitrification Fields	1	# Lines	3		Linear Ft:	267'	Maintenance Agreement Required:	☒ YES	☐ NO		
Trench Width	24"	Max. Trench Bottom Depth	* 33" *		Gravel Depth	N/A		☐ GRAVITY	☒ PRESSURE		

☒ Residence	No. Bedrooms	4	Water Supply		
☐ Business	No. Persons	8	☒ Private		
☐ Other	No. Employees		☐ Public		
☐ Slab	☐ Crawl Space		☐ Community		
☒ Basement w/plumbing			☐ Basement w/o plumbing		


Comments / Conditions: Old Road Bed & Rough Topo will need to be properly filled. Tanks can be 5' from house if below floor level, otherwise 15' from basement.

Any well must be 100' from repair area and minimum 50' from initial area. Maintain 15' from drainage and culvert pipe. With 1 drainfield.

INITIAL SITE SKETCH

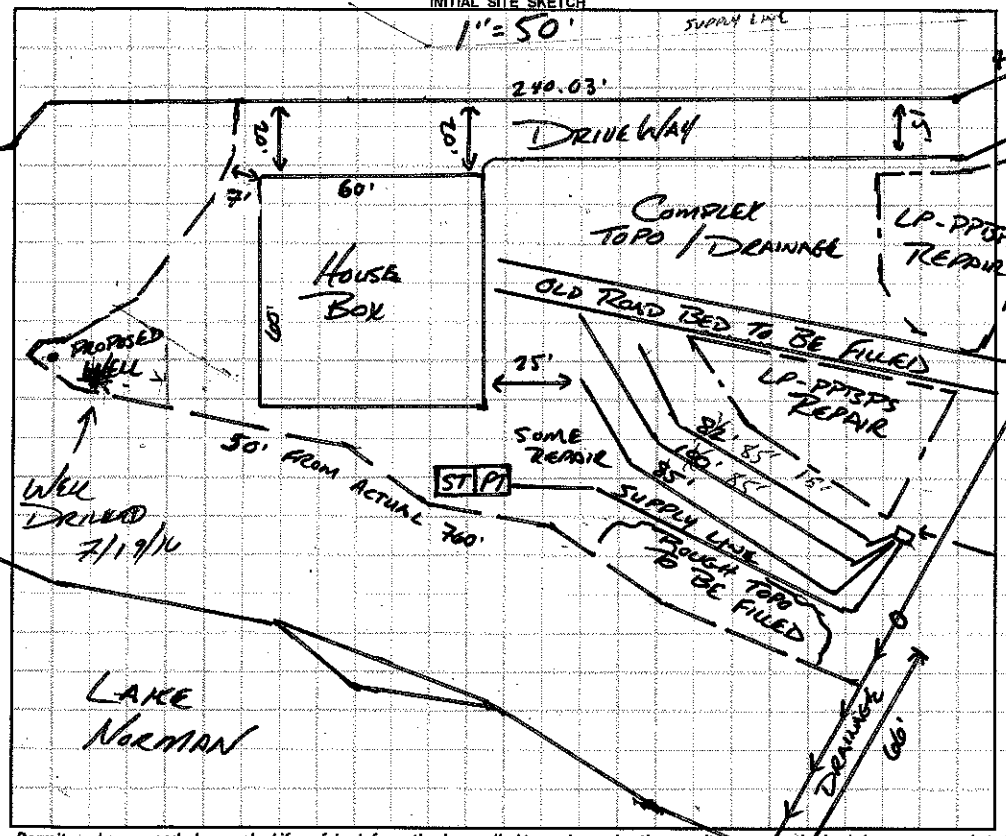

AS BUILT SKETCH

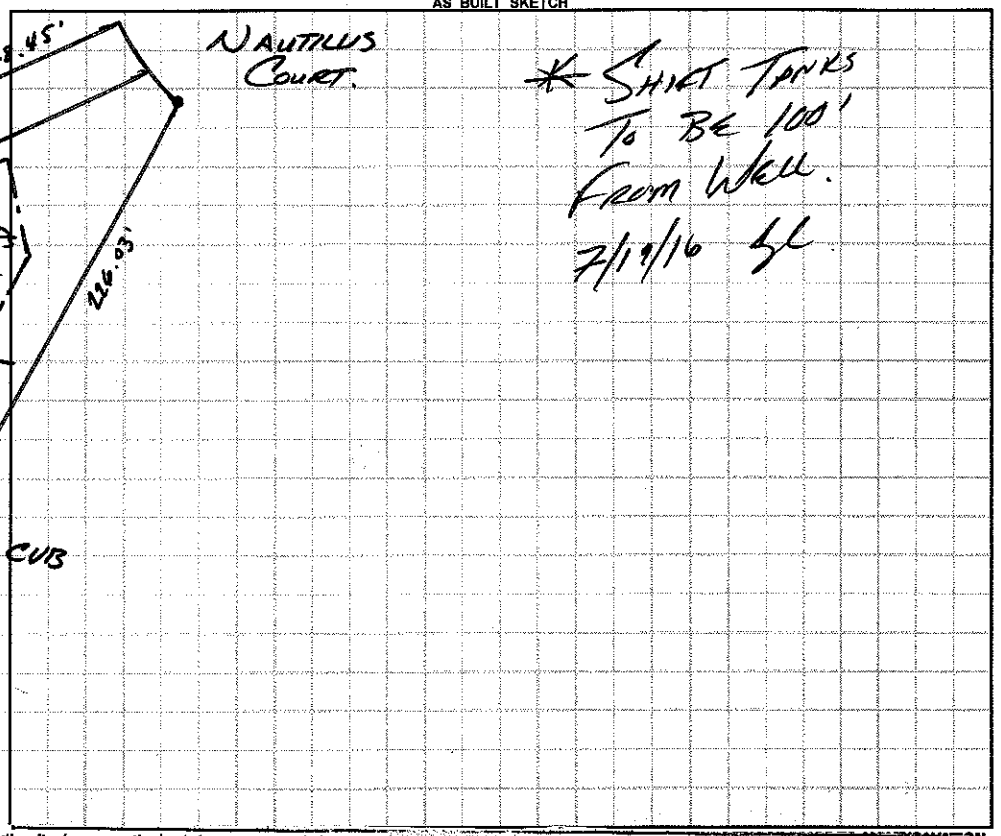

Permit can be suspended or revoked if any false information is supplied toward securing the permit / any unauthorized changes are made to the site / any unauthorized changes are made in the ins[illegible] system. CONTACT A LOCATOR SERVICE PRIOR TO ANY EXCAVATION

☐ IMPROVEMENT PERMIT *with plat* valid without expiration. ☒ IMPROVEMENT PERMIT *with site plan* valid for 60 mos. ☐ AUTHORIZATION TO CONSTRUCT [illegible] Period equal to IMPROVEMENT PERMIT – not to exceed 60 mo.

Owner / Applicant Signature: Date: 10-5-15 Installed by: Dustin Grady

IMPROVEMENT PERMIT by: APPROVED SEP 24 2015 OPERATION PERMIT by: B Colladay / W Sparks Date: 10/3/16

AUTHORIZATION TO CONSTRUCT by: Date: 3-3-16 Existing System Inspected by: Date:

Health Dept. Copy - WHITE Applicant (Final Approval) - YELLOW Applicant (Conditional Approval) - PINK