IREDELL COUNTY HEALTH DEPARTMENT

STATESVILLE 704-878-5305 MOORESVILLE 704-664-5281

IMPROVEMENT PERMIT / AUTHORIZATION TO CONSTRUCT / OPERATION PERMIT / EXISTING SYSTEM INSPECTION

PERMIT# 08C147 PIN# 4639734457 (pt.) 4629-43-9395 DATE Dec. 22, '99

OWNER OR CONTRACTOR Crescent Resources Inc. PHONE: Business Home

ADDRESS P.O. Box 1003 Charlotte

LOCATION State Park Road TL Morrison Farm Rd. TR Apollo Rd. TL Nautilus Court 1st lot on left

SUBDIVISION Harbor Bay BLOCK / SECTION LOT 31 LOT AREA 52,439 ft² SITE CLASS AS DESIGN FLOW 480 gpd L.T.A.R. ~.25

Septic Tank: 1000 Gallons; STB 794 Date 2-20-03

Pump Tank: 1000 Gallons; PT 283 Date 8-22-03

Pump Make: SAULDS Model WGD511H Serial No. E0358769

Nitrification Field: No Fields 1 Square Feet 1050 Linear Feet 350

No Lines 5@70' Trench Width 36" Max Trench Bottom Depth 36"

☑ New System ☐ Repair System Type: I, II, III, IV, V, VI

System Description: LPP Panel Block

Repair System Description: SAME

Maintenance Agreement Required: ☐ Yes ☐ No

☑ House/Mod. Home No. Bedrooms 4

☐ Mobile Home No. Bathrooms 4

☐ Business No. Employees

☐ Other


Water Supply: ☑ Individual ☐ Public ☐ Community

Gravel Depth N/A ☑ Slab ☑ Crawl Space ☐ Basement w/plumbing ☑ Basement wo/plumbing


Comments:/Conditions: Any plumbing in basement will require the use of an in house pump to lift to main level plumbing in order to maintain a 100' minimum well & septic system separation.

Comments:/Conditions: (PARTIAL) TO DRAINLINES INSPECTED 9-29-03 OK OF CONTOUR 2'4", SOIL CHARACTERISTICS OK, ~~APPROVED~~ AFTER REVIEW - RSH. Electrical & Alarm, Pressure check - okay 11-14-03. WOJ.

INITIAL SITE SKETCH 1"=50'

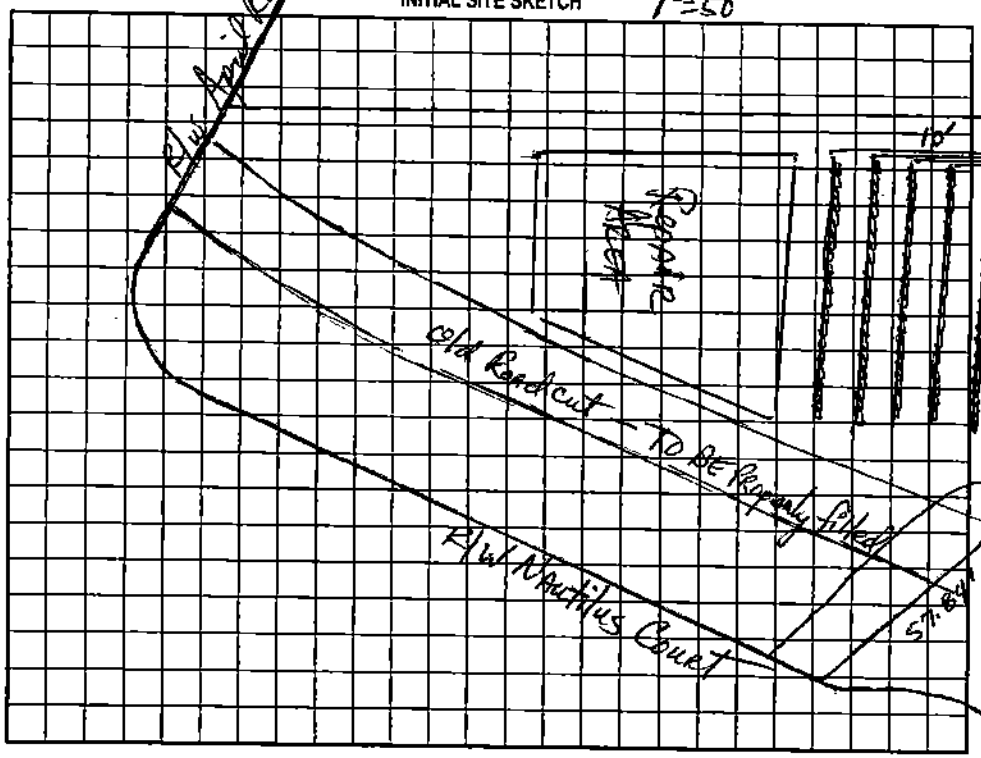

AS BUILT SKETCH

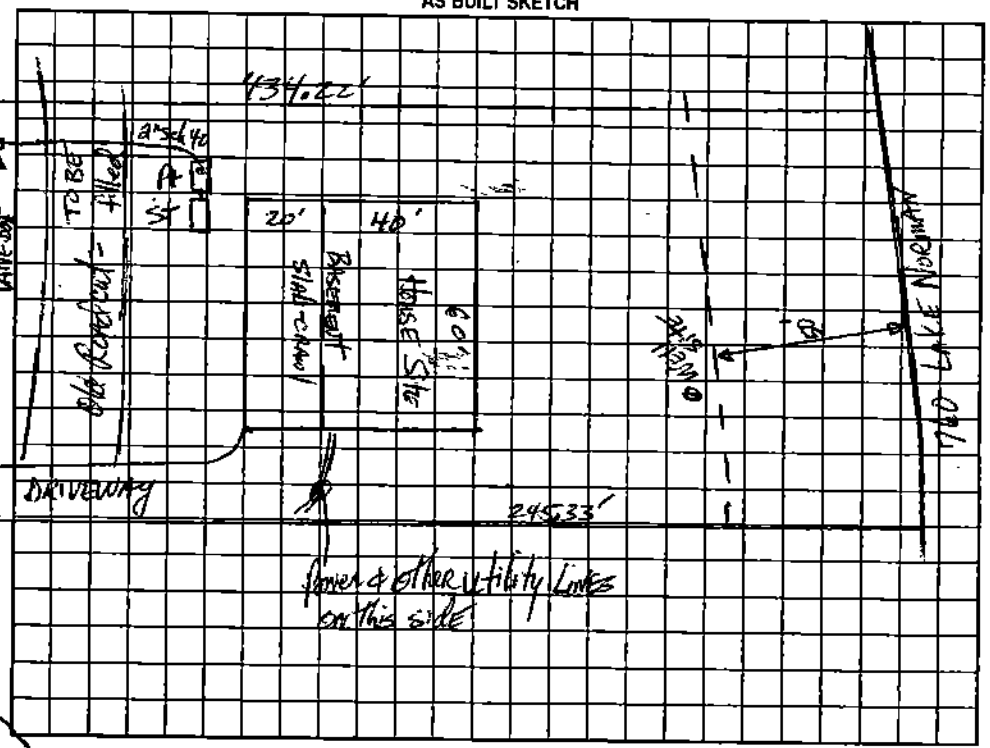

Permit can be suspended or revoked if any false information is supplied toward securing the permit/any unauthorized changes are made to the site/any unauthorized changes are made in the installation of the system. Improvement Permit with plat valid without expiration. Improvement Permit with site plan valid for sixty months. Authorization to Construct is valid for a period equal to that of Improvement Permit – not to exceed sixty months.

Signed: Kelly G. Penry date 1-14-00

Improvement Permit by: [signature] date 12-22-99

Authorization to Construct by: [signature] date 07/15/03

Installed by: Dave Clark

Operation Permit by: William O. Johnson date 1/30/04

Existing System Inspection by: date

HEALTH DEPT. COPY: WHITE OWNER COPY (FINAL): YELLOW OWNER COPY (INITIAL): PINK