1135 F J ERVIN

IREDELL COUNTY HEALTH DEPARTMENT

THIS PERMIT VOIDS PREVIOUS ISSUED 10-21-98

STATESVILLE 704-878-5305 MOORESVILLE 704-664-5281

IMPROVEMENT PERMIT / AUTHORIZATION TO CONSTRUCT / OPERATION PERMIT / EXISTING SYSTEM INSPECTION

PERMIT# 074564 PIN# [redacted] 4629 49 5726 DATE 2-10-2000

OWNER OR CONTRACTOR BRIAN R. GRIEP PHONE: Business (704) 896-8283 Home (704) 895-9081

ADDRESS 19460 OLD JETTON ROAD, CORNELIUS, NC, 28031

LOCATION STATE PARK RD, TL WILDLIFE RD, TR SIERRA, TL DEER RUN, TR EAGLE CHASE, LOT AT END

SUBDIVISION WILDLIFE BAY BLOCK / SECTION I LOT 51 & 51A LOT AREA 44,789 SF (TOT) SITE CLASS PS DESIGN FLOW 480 L.T.A.R. 0.30 GPD/FT²

Septic Tank: 1000 Gallons: STB 3/2 Date 5-8-00
Pump Tank: 1000 Gallons: PT 27 Date 5/16/00
Pump Make: Gould Model WE10I2 H Serial No. C005698 4
Nitrification Field: No Fields 1 Square Feet 50 @ 1600 Linear Feet 400+
No Lines SIX Trench Width 36" Max Trench Bottom Depth 36"

☒ New System ☐ Repair System Type: I II III IV V VI
System Description: 25% REDUCTION, PUMP
Repair System Description: 50% REDUCTION PUMP
Maintenance Agreement Required: ☐ Yes ☒ No
Gravel Depth SAND 6" ☐ Slab ☐ Crawl Space ☒ Basement w/plumbing ☐ Basement wo/plumbing

☒ House/Mod. Home No. Bedrooms 3
☐ Mobile Home No. Bathrooms 4
☐ Business No. Employees
☐ Other + OFFICE


Water Supply: ☐ Individual ☒ Public ☐ Community

Comments./Conditions: ① INSTALL 25% REDUCTION SYSTEM USING SIXTY-SIX (66) CHAMBERS (AT OWNERS REQUEST) IN SIX EQUAL LENGTH LINES AS SHOWN ② SEE ATTACHED SHEETS FOR PUMP & PRESSURE MANIFOLD REQUIREMENTS

Comments./Conditions: EAGLE CHASE LN 717 - Zable Filter used CUL-DE-SAC Pressure Set Tank & Lines Inspected

SCALE: 1" = 50'

INITIAL SITE SKETCH

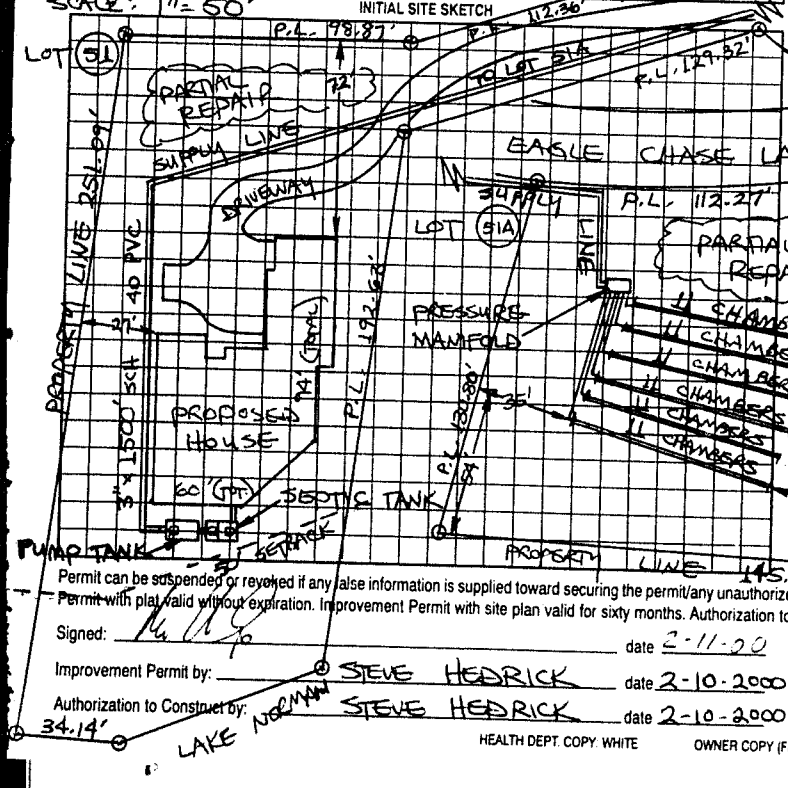

AS BUILT SKETCH

System Installed As Designed

Permit can be suspended or revoked if any false information is supplied toward securing the permit/any unauthorized changes are made to the site/any unauthorized changes are made in the installation of the system. Improvement Permit with plat valid without expiration. Improvement Permit with site plan valid for sixty months. Authorization to Construct is valid for a period equal to that of Improvement Permit – not to exceed sixty months.

Signed: _____ date 2-11-20 Installed by: F J ERVIN

Improvement Permit by: STEVE HEDRICK date 2-10-2000 Operation Permit by: _____ date 10/13/00

Authorization to Construct by: STEVE HEDRICK date 2-10-2000 Existing System Inspection by: _____ date _____

HEALTH DEPT. COPY: WHITE OWNER COPY (FINAL): YELLOW OWNER COPY (INITIAL): PINK