IREDELL COUNTY HEALTH DEPARTMENT

STATESVILLE 704-878-5305 CI MOORESVILLE 704-664-5281

IMPROVEMENT PERMIT / AUTHORIZATION TO CONSTRUCT / OPERATION PERMIT / EXISTING SYSTEM INSPECTION

PERMIT# 074562 PIN# 4639734550 PT DATE 10/6/98

OWNER OR CONTRACTOR Crescent Resources PHONE: Business 663-6905 Home

ADDRESS P.O. Box 1003 Charlotte, NC 28201

LOCATION State Park Rd TL Wildlife TR Sierra TL Deer Run TR Eagle Chase on left of Cul-de-Sac

SUBDIVISION Wildlife Bay BLOCK / SECTION I LOT 49 LOT AREA .71 Acre SITE CLASS PS DESIGN FLOW 480gpd L.T.A.R. .3

Septic Tank: 1000 Gallons; STB 760 Date 11-30-01

Pump Tank: 1000 Gallons; PT 189 Date 11-30-01

Pump Make: Little Giant Model 4EHOM Serial No. AJA10002

Nitrification Field: No Fields 1 Square Feet 1266' Linear Feet 400'

No Lines 6at67' Trench Width 36" Max Trench Bottom Depth 36" Gravel Depth N/A

[X] New System [ ] Repair System Type: I, II, III, IV, V, VI

System Description: Pump-PM-25% Reduction

Repair System Description: Same

Maintenance Agreement Required: [ ] Yes [X] No

[X] House/Mod. Home No. Bedrooms 4

[ ] Mobile Home No. Bathrooms 4

[ ] Business No. Employees

[ ] Other


[ ] Slab [X] Crawl Space [X] Basement w/plumbing [ ] Basement wo/plumbing

Water Supply: [ ] Individual [X] Public [ ] Community


Comments:/Conditions: Keep Septic System at least 10' From PL & 50' From Lake

Comments:/Conditions: Partial Infiltrator Chambers Inst'd & -Prior HD approval to move ST+PT. -2 bed filter Installed Trailer Inspected 6/18/02 / Lines, PM, + Pressure check - 6/19/02

INITIAL SITE SKETCH

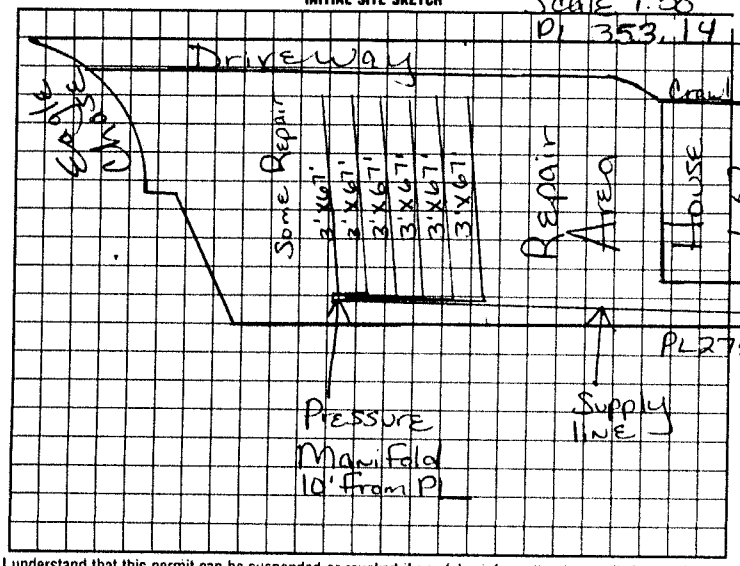

AS BUILT SKETCH

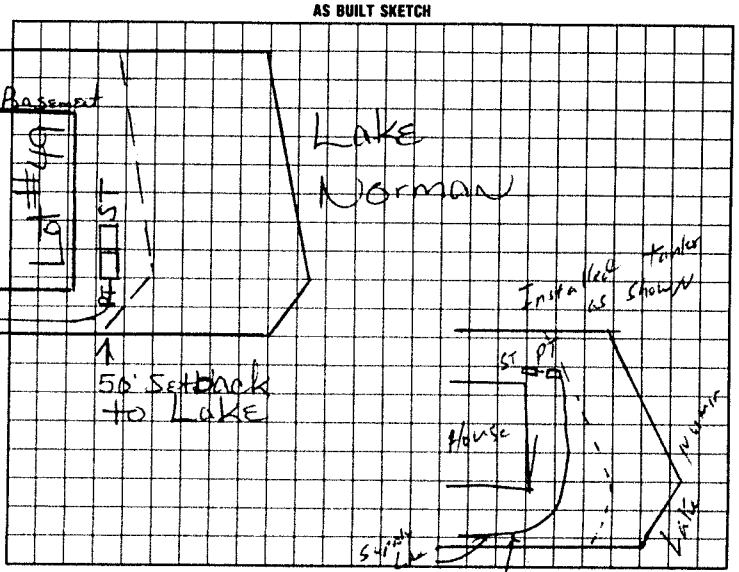

I understand that this permit can be suspended or revoked if any false information is supplied toward securing the permit/any unauthorized changes are made to the site/any unauthorized changes are made in the installation of the system. Improvement Permit with plat valid without expiration. Improvement Permit with site plan valid for sixty months. Authorization to Construct is valid for a period equal to that of Improvement Permit – not to exceed sixty months.

Signed: Paul C. Pennington date 6-23-98 Installed by: Marty Carter

Improvement Permit by: Maria H. Hodgson date 10/6/98 Operation Permit by: William E. Johnson date 12/30/02

Authorization to Construct by: William E. Johnson date 4/3/02 Existing System Inspection by: _____ date _____

HEALTH DEPT. COPY: WHITE INSPECTION COPY (FINAL): GREEN OWNER COPY (FINAL) YELLOW INSPECTION COPY (INITIAL): PINK OWNER COPY (INITIAL): GOLD