IREDELL COUNTY HEALTH DEPARTMENT

THIS PERMIT VOIDS PREVIOUS ISSUED 9/17/98

STATESVILLE 704-878-5305 MOORESVILLE 704-664-5281

IMPROVEMENT PERMIT / AUTHORIZATION TO CONSTRUCT / OPERATION PERMIT / EXISTING SYSTEM INSPECTION

PERMIT# 116318 PIN# 4629-49-8744 DATE 10-30-03

OWNER OR CONTRACTOR JOHN & PAMELA HUNT PHONE: Business 336-716-2162 Home 336-760-9551

ADDRESS 320 SPRINGWATER COURT, WINSTON-SALEM, NC 27106

LOCATION STATE PARK ROAD TO WILDLIFE ROAD, TR SIERRA WOODS T'L DEER RUN TR EAGLE CHASE AT END ON LEFT

SUBDIVISION WILDLIFE BAY BLOCK / SECTION I LOT 48 LOT AREA 0.86 ACRE SITE CLASS PS1 DESIGN FLOW 480 L.T.A.R. 0.30 GPD/FT²

Septic Tank: 1000 Gallons; STB 312 Date 3-19-04

Pump Tank: 1000 Gallons; PT 27 Date 3-16-04

Pump Make: MYERS, Model ME 503-21 Serial No.

Nitrification Field: No Fields 1 Square Feet 1600 Linear Feet 400

No Lines SIX Trench Width 36" Max Trench Bottom Depth 36" Gravel Depth N/A

☑ New System ☐ Repair System Type: I, II, III, IV, PUMP

System Description: 25% REDUCTION

Repair System Description: 25% REDUCTION, PUMP

Maintenance Agreement Required: ☐ Yes ☑ No

☑ House/Mod. Home ☐ Mobile Home ☐ Business ☐ Other

No. Bedrooms 4 No. Bathrooms 4.5 No. Employees


☐ Slab ☐ Crawl Space ☑ Basement w/plumbing ☐ Basement wo/plumbing

Water Supply: ☐ Individual ☑ Public ☐ Community


Comments/Conditions: ① INSTALL 25% REDUCTION SYSTEM IN SIX EQUAL LENGTH LINES ON CONTOUR AS SHOWN ② KEEP SYSTEM MINIMUM 50' FROM HIGH WATER LINE 10' FROM PROPERTY LINE, 10' FROM WATER LINE ③ KEEP SUPPLY LINE MINIMUM 5' FROM PROPERTY LINE.

Comments/Conditions: SEPTIC TANK WITH RISERS INSTALLED USING "POLY LOK" FILTER - TANKS & LINER INSPECTED 4-20-04 RSH EVERYTHING ELSE V'D 6-4-04 DIC

INITIAL SITE SKETCH

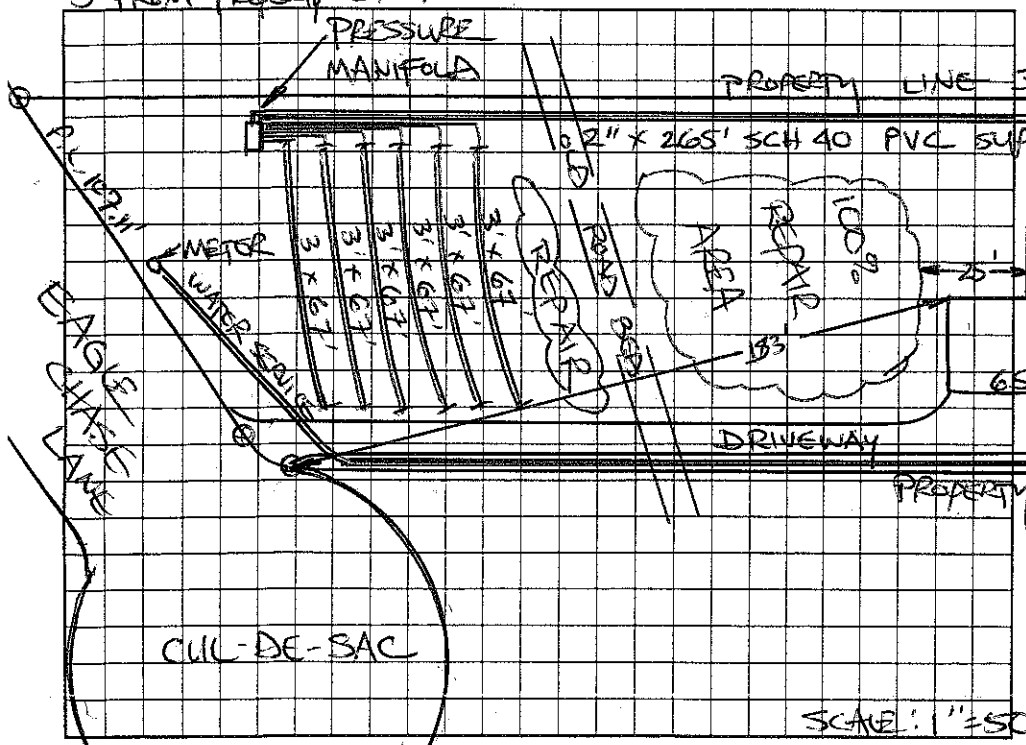

AS BUILT SKETCH

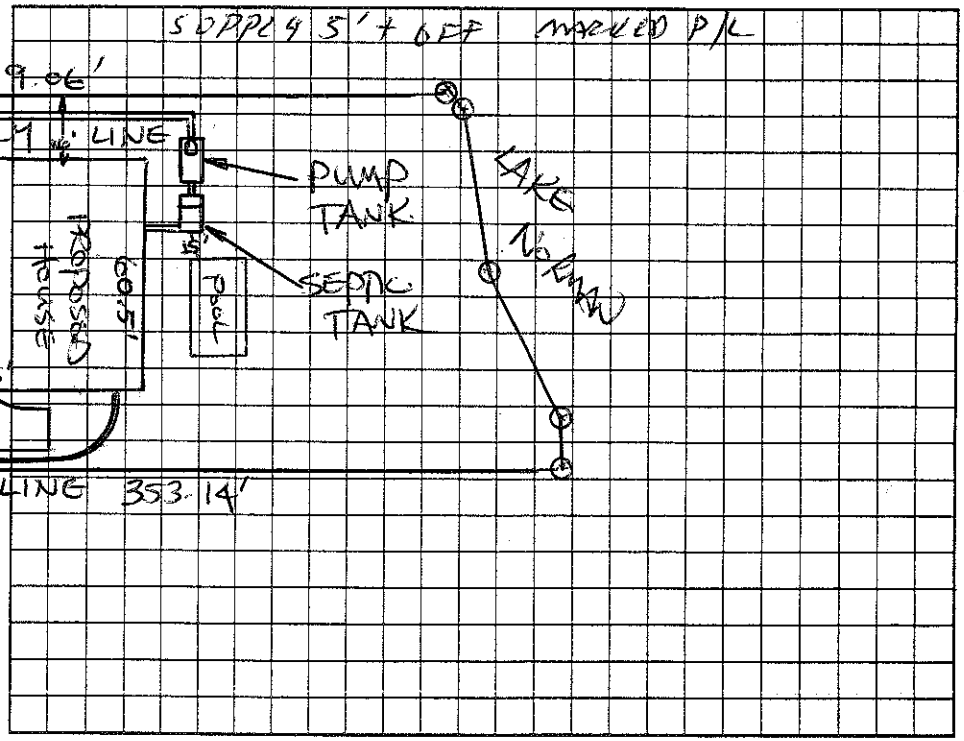

Permit can be suspended or revoked if any false information is supplied toward securing the permit/any unauthorized changes are made to the site/any unauthorized changes are made in the installation of the system. Improvement Permit with plat valid without expiration. Improvement Permit with site plan valid for sixty months. Authorization to Construct is valid for a period equal to that of Improvement Permit -- not to exceed sixty months.

Signed: X [signature] date 10-30-03

Improvement Permit by: STEVE HEDRICK date 10-30-03

Authorization to Construct by: STEVE HEDRICK date 10-30-03

Installed by: R & H OF LAKE NORMAN

Operation Permit by: [signature] date 6-4-04

Existing System Inspection by: date

HEALTH DEPT. COPY: WHITE OWNER COPY (FINAL): YELLOW OWNER COPY (INITIAL): PINK