IREDELL COUNTY HEALTH DEPARTMENT

Statesville Phone TR 3-7271 Mooresville Phone NO 3-1271

PERMIT TO INSTALL SEPTIC TANK

Permit NO. Nelson Brown Permit Date 3-18 1968

Owner John Reich Address City

Installed By C Hoke Address RFD


Location of Property Sunset Point. Sec 17 - Lot 108

Tank		Capacity		Length of Lines		Fixtures	
Block	( )	1000	( )	225'	( )	No. of Baths	( )
Precast	(✓)	1250	( )	250'	( )	Dishwasher	( )
		1500	( )	Other		Garbage Grdr..	( )
		Other				Other Cabin	

NOTIFY HEALTH DEPARTMENT AT LEAST EIGHT HOURS BEFORE TANK IS TO BE INSPECTED.

Final Inspection 19 Approved ( ) Disapproved ( )

Remarks Slope to River - Very Hard - Not good soil - well 100ft.

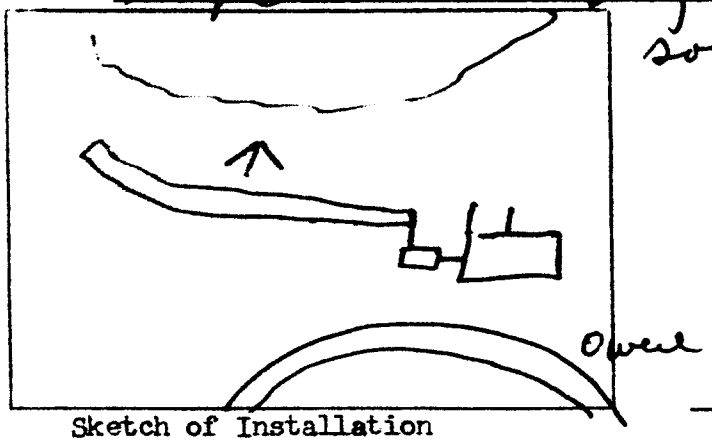

Sketch of Installation

Sanitarian