IREDELL COUNTY HEALTH DEPARTMENT

STATESVILLE 704-878-5305 MOORESVILLE 704-664-5281

IMPROVEMENT PERMIT / CERTIFICATE OF COMPLETION / OPERATION PERMIT / EXISTING SYSTEM INSPECTION

PROPERTY DESCRIPTION NO. 68624 DATE 8-11-97 TAX MAP NO. 4629 51 6083 Watershed: ☑ Yes ☐ No

OWNER OR CONTRACTOR William Eubanks PHONE: Business Home 704 537 1337 ~~LOW~~ IV CA

ADDRESS 4400 Hobbs Hill Rd Charlotte N.C.

LOCATION State Pk Rd Turn Morrison Fm TR Penicillin Pt. 198 Penicillin Pt.

SUBDIVISION Lakeview acres BLOCK / SECTION LOT 49 LOT AREA .75 acres SITE CLASS PS DESIGN FLOW 360 L.T.A.R. .3

Septic Tank Ex 1000 Gallons; STB Date

Pump Tank: Gallons; PT Date

Pump Make: Model Serial No.

Nitrification Field: No Fields 1 Square Feet 160 Linear Feet 80

No Lines 1 Trench Width 24" Max Trench Bottom Depth 36" 40 Ngs"

☐ New System ☑ Repair System Type: I, II, III, IV, V, VI

System Description: Panels

Repair System Description: Gravity ~~Chamber~~

Maintenance Agreement Required: ☐ Yes ☐ No

Gravel Depth N/A ☐ Slab ☐ Crawl Space ☑ Basement w/plumbing ☐ Basement wo/plumbing

☑ House/Mod. Home No. Bedrooms 3

☐ Mobile Home No. Bathrooms 3

☐ Business No. Employees


☐ Other

Water Supply: ☐ Individual ☑ Community ☐ Public


Comments: Adding Bedroom TO Existing House

Comments: - Built New House 2001
- Added New System that ties bottom of line to new panel back line - Post Insp.

INITIAL SITE SKETCH 215'

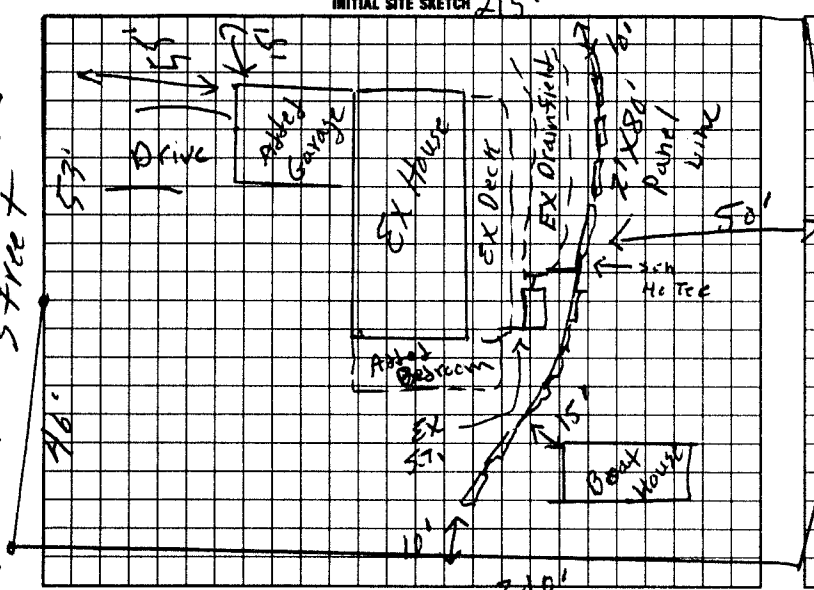

Not to Scale AS BUILT SKETCH

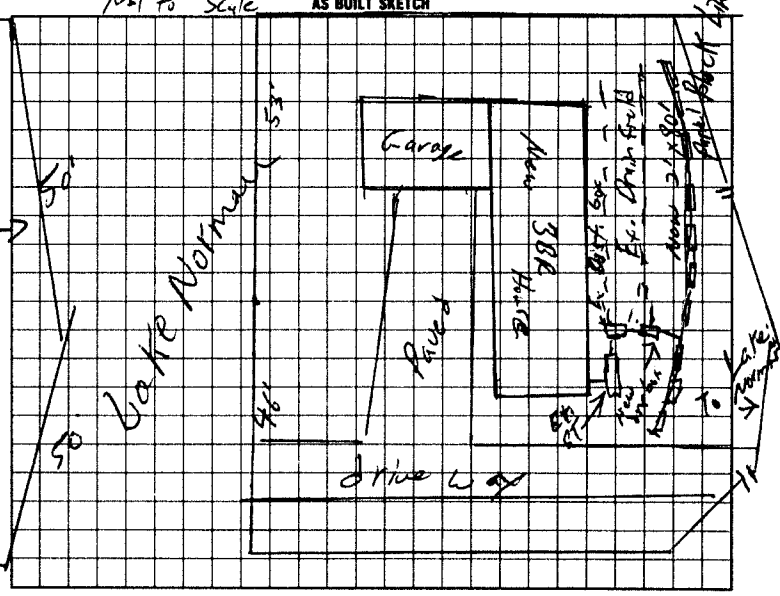

I understand that this permit can be suspended or revoked if any false information is supplied toward securing the permit/any unauthorized changes are made to the site/any unauthorized changes are made in the installation of the system. Improvement Permit is valid for 60 months from date of issuance.

Signed: William M. Eubanks

Improvement Permit by: L.C. Moore date 8-11-97

~~Authorization~~ by: L.C. Moore date 8-11-97

to Const.

Installed by: Tommy Fyke

Certificate of Completion by: William A. Johnson date 8/20/01

Operation Permit by: date

HEALTH DEPT. COPY: WHITE INSPECTION COPY (FINAL): GREEN OWNER COPY (FINAL): YELLOW INSPECTION COPY (INITIAL): PINK OWNER COPY (INITIAL): GOLD

Authorization to const Expires 60 mos. from issue