IREDELL COUNTY HEALTH DEPARTMENT

4629-51-8213

STATESVILLE 704-878-5305 MOORESVILLE 704-664-5281

IMPROVEMENT PERMIT / AUTHORIZATION TO CONSTRUCT / OPERATION PERMIT / EXISTING SYSTEM INSPECTION

PERMIT# 19909 76958 PIN# 3C-6-A-121-C Tax map DATE 8-28-98

OWNER OR CONTRACTOR Tony Elliott PHONE: Business Home 872 1968

ADDRESS 161 Tremont Lane Troutman N.C.

LOCATION State Park Rd TL morrison Fm Rd TR Pencillin Pt Near End on Rt

SUBDIVISION Lake Norman BLOCK / SECTION 17 LOT 851 LOT AREA .5 acres SITE CLASS. PS DESIGN FLOW 360 L.T.A.R. .3

Septic Tank: 1000 Gallons; STB 1012 Date 5 21 99

Pump Tank: 1000 Gallons; PT Date 3 9 99

Pump Make: Hydro Matic Model SHEF HPA2 Serial No. Date Code 3-99

Nitrification Field: No Fields 1 Square Feet 400 Linear Feet 200

No Lines 6 Trench Width 24" Max Trench Bottom Depth 36" Gravel Depth N/A

☑ New System ☐ Repair System Type: I, II, III, IV, V, VI

System Description: Pressure Dosed Panel II II II

Repair System Description:

Maintenance Agreement Required: ☑ Yes ☐

☑ House/Mod. Home No. Bedrooms 3

☐ Mobile Home No. Bathrooms 2½

☐ Business No. Employees

☐ Other

☐ Slab ☐ Crawl Space ☑ Basement w/plumbing ☐ Basement wo/plumbing


Water Supply: ☑ Individual ☐ Public ☐ Community

Comments/Conditions:


Comments/Conditions: Replaces Permit Issued To Bruce Guill 12-29-94

See Detail sheets for Pump Tank + Pressure Line set up. A Certified operator must be on contract before operations permit can be issued

INITIAL SITE SKETCH

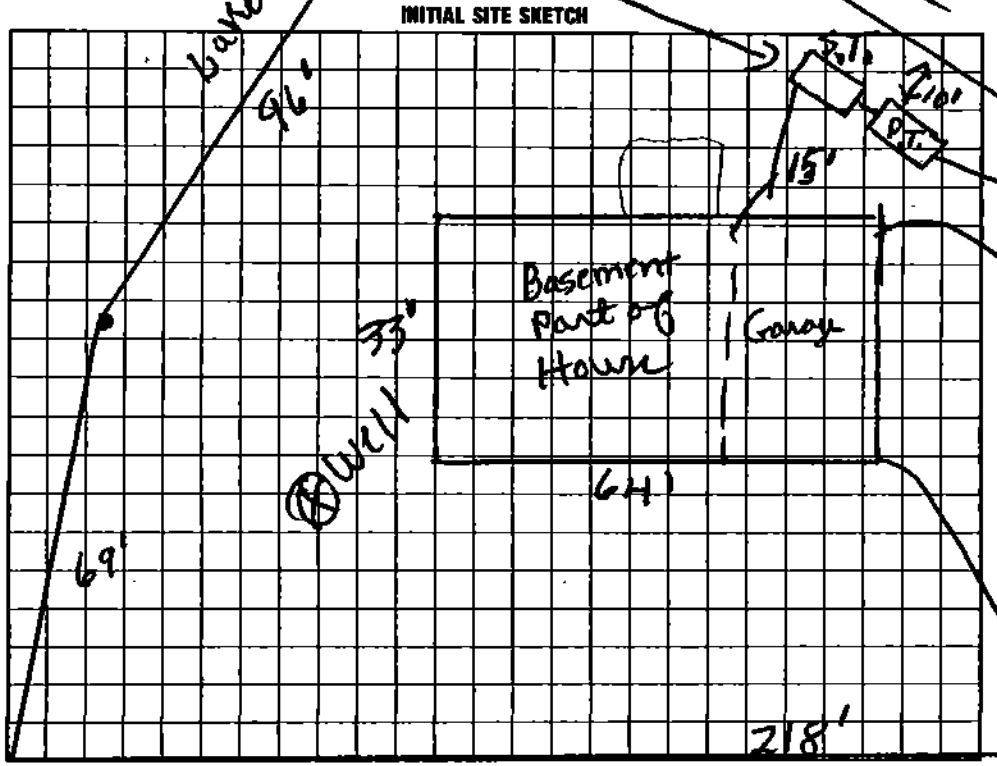

AS BUILT SKETCH

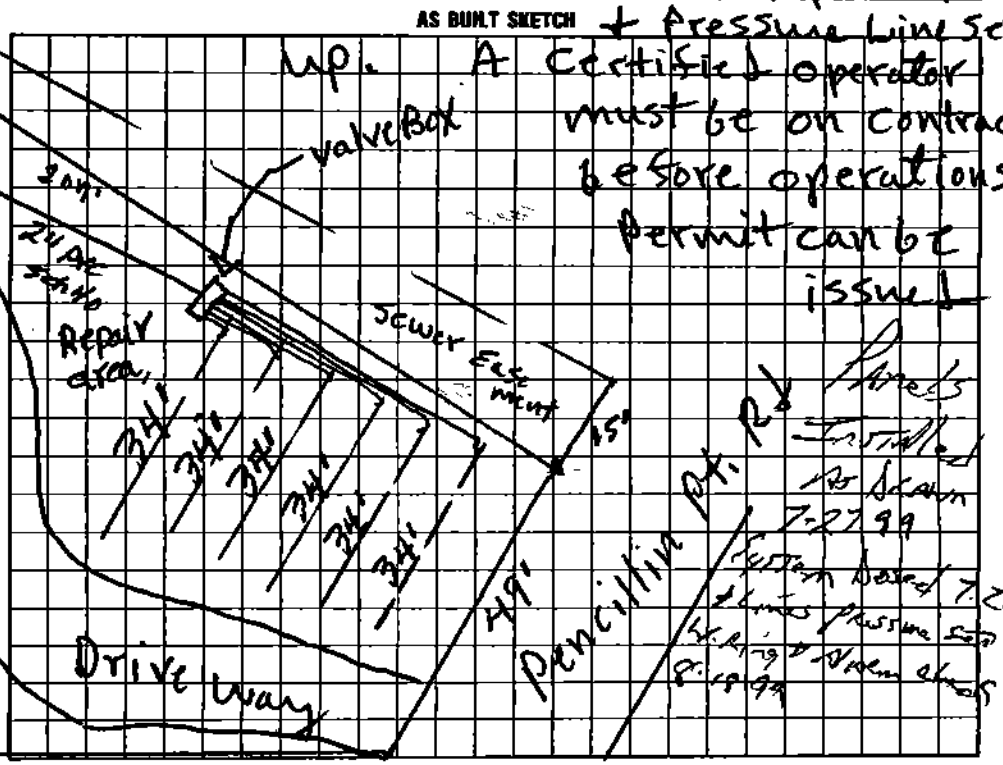

I understand that this permit can be suspended or revoked if any false information is supplied toward securing the permit/any unauthorized changes are made to the site/any unauthorized changes are made in the installation of the system. Improvement Permit with plat valid without expiration. Improvement Permit with site plan valid for sixty months. Authorization to Construct is valid for a period equal to that of Improvement Permit – not to exceed sixty months.

Signed: [signature] date 8/28/98 Installed by: Al Backhoe

Improvement Permit by: R. C. Moore date 8-28-98 Operation Permit by: [signature] date Aug 18 99

Authorization to Construct by: R. C. Moore date 8-28-98 Existing System Inspection by: date

HEALTH DEPT. COPY: WHITE INSPECTION COPY (FINAL): GREEN OWNER COPY (FINAL): YELLOW INSPECTION COPY (INITIAL): PINK OWNER COPY (INITIAL): GOLD