IREDELL COUNTY HEALTH DEPARTMENT

CI

STATESVILLE 704-878-5305 MOORESVILLE 704-664-5281

IMPROVEMENT PERMIT / AUTHORIZATION TO CONSTRUCT / OPERATION PERMIT / EXISTING SYSTEM INSPECTION

PERMIT# 139795 PIN# 4629 52 0370 DATE 1-29-07

OWNER OR APPLICANT CINDY & RICHARD [redacted] Wright PHONE: Business _____ Home 704-528-4471

ADDRESS 113 TINKER PL TROUTMAN NC 28166

LOCATION Stak Pen RD (L) Morrison Farm (R) APRIL (L) WINDWOOD (R) TINKER PL 2ND LOT / HOUSE TO LEFT AT BOX #113

SUBDIVISION CL & T BLOCK / SECTION 17 LOT BSD LOT AREA .858 AC SITE CLASS. AS DESIGN FLOW 480 L.T.A.R. .3 TOTAL

EXISTING

Septic Tank: 1000 Gallons: STB _____ Date _____

Pump Tank: _____ Gallons: PT _____ Date _____

Pump Make: _____ Model _____ Serial No. _____

Nitrification Field: No Fields 1 Square Feet 510=600 Linear Feet 133'

No Lines 3 Trench Width 24" Max Trench Bottom Depth 36" Gravel Depth N/A

☐ New System ☐ Repair ☒ Expansion System Type: I II III IV V VI

System Description: CONVETT 50% REDUCTION

Repair System Description: Protrudent 50% REDUCTION

Maintenance Agreement Required: ☐ Yes ☒ No

☒ House/Mod. Home ☐ Mobile Home ☐ Business ☒ ☐ Other ADDING 2 BEDROOM

No. Bedrooms 2/4 No. Persons 8 No. Employees ____


☐ Gravity ☐ Pressure ☐ Slab ☐ Crawl Space ☒ Basement w/plumbing ☐ Basement wo/plumbing

Water Supply: ☒ Individual ☐ Public ☐ Community

Comments/Conditions: (1) MEET PRIOR TO INSTALLATION FOR CONSULTATIVE VISIT (2) INSTALL 3 NEW 50% REDUCTION LINES AS DETAILED; (3) INSTALL LINES ON CONTOURS & MAINTAIN SETBACKS

Comments/Conditions: THIS IS AN EXPANSION. ADDING 2 BEDROOMS SYSTEM TO A PROPERLY FUNCTIONING 2 BEDROOM SYSTEM. BRINGS TOTAL UP TO 4 BEDROOMS.

INITIAL SITE SKETCH NOT TO SCALE

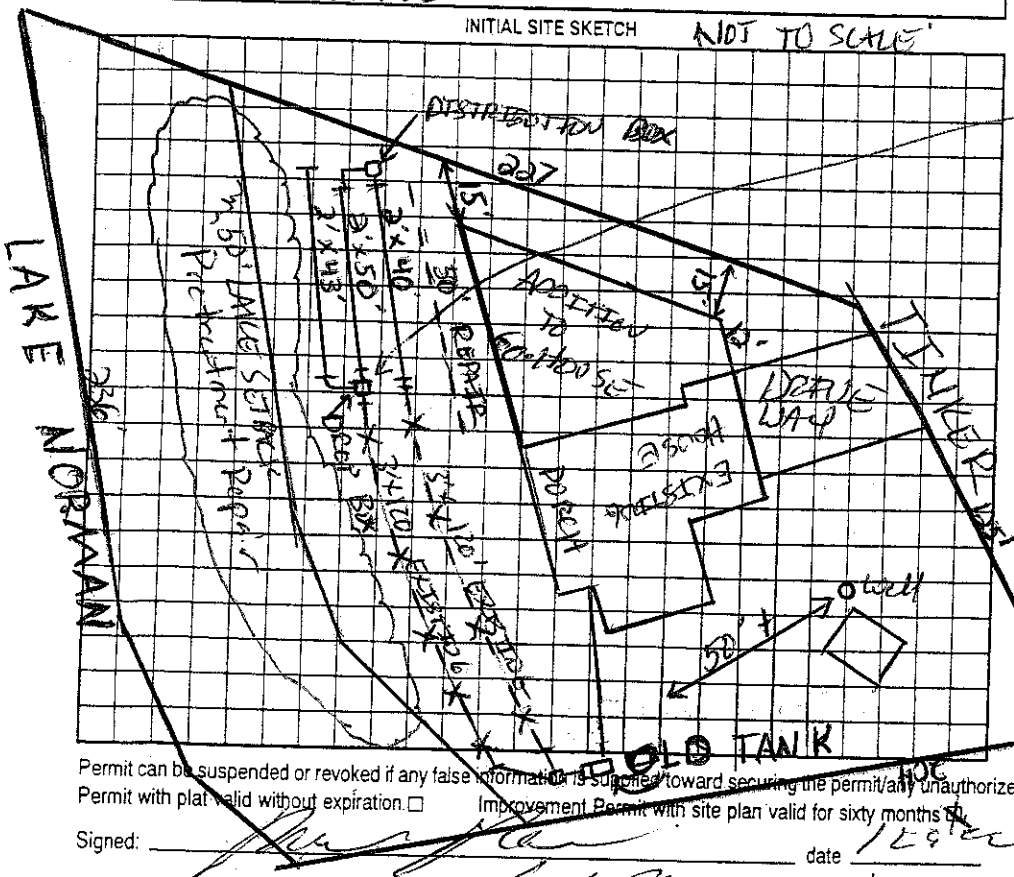

AS BUILT SKETCH

to second 120 line

This box not connected and system designed so 1st line will back up and feed new 2 Bedroom EXPANSION, by laser elevation shooting, IF ANY PROBLEM arises in future this box can be connected to new 3rd 30'x20' line to feed system.

Permit can be suspended or revoked if any false information is supplied toward securing the permit/any unauthorized changes are made to the site/any unauthorized changes are made in the installation of the system. Improvement Permit with plat valid without expiration. ☐ Improvement Permit with site plan valid for sixty months ☒ Authorization to Construct is valid for a period equal to that of Improvement Permit – not to exceed sixty months.

Signed: _____ date 1/29/07 Installed by: A-1 BACKHOE

Improvement Permit by: _____ date 1-29-07 Operation Permit by: _____ date 9/19/07

Authorization to Construct by: _____ date 1-29-07 Existing System Inspection by: _____ date _____

HEALTH DEPT. COPY: WHITE OWNER COPY (FINAL): YELLOW OWNER COPY (INITIAL): PINK