This permit voids previously issued permit dated 1/10/00. CI

IREDELL COUNTY HEALTH DEPARTMENT

STATESVILLE 704-878-5305 MOORESVILLE 704-664-5281

IMPROVEMENT PERMIT / AUTHORIZATION TO CONSTRUCT / OPERATION PERMIT / EXISTING SYSTEM INSPECTION

PERMIT# 086162 PIN# ~~4637-73-4457 (pt)~~ 4629-52-0558 DATE 9/8/03

OWNER OR CONTRACTOR Stephen Beck PHONE: Business (704) 224-3946 Home

ADDRESS 215 Bear Popular Rd Cleveland N.C. 27013

LOCATION State Park Rd, (L) Morrow Farm Rd (R) April Rd (L) Windwood Lane on (R) at Junction of Tiffany Place

SUBDIVISION Hawkes Bay BLOCK / SECTION LOT 45 LOT AREA 84,554 SF SITE CLASS. P5 DESIGN FLOW 440 L.T.A.R. .30

Septic Tank: 1000 Gallons; STB 794 Date 8-22-04
Pump Tank: 1000 Gallons; PT 27 Date 8-22-04
Pump Make: ZOELLER Model BN 140-C Serial No.
Nitrification Field: No Fields 1 Square Feet Engineer 1600 Linear Feet 400
No Lines 4@100' Trench Width 36" Max Trench Bottom Depth 36" Gravel Depth N/A

[X] New System [ ] Repair System Type: I, II, III, IV, V, VI
System Description: Pump, 25% Red.
Repair System Description: Pump, 25% Reduction
Maintenance Agreement Required: [ ] Yes [X] No


[X] House/Mod. Home No. Bedrooms 4
[ ] Mobile Home No. Bathrooms 4
[ ] Business No. Employees
[ ] Other
[ ] Slab [ ] Crawl Space [X] Basement w/plumbing [ ] Basement wo/plumbing

Water Supply: [X] Individual [ ] Public [ ] Community


Comments/Conditions:

Comments/Conditions: TANK & LINES INSPECTED 10-1-04, PRESSURE CHECKED O.K. RSH. SEPTIC TANK W/RISERS AND MARKER INSTALLED USING "ZABEL" FILTER

INITIAL SITE SKETCH 1"=60'

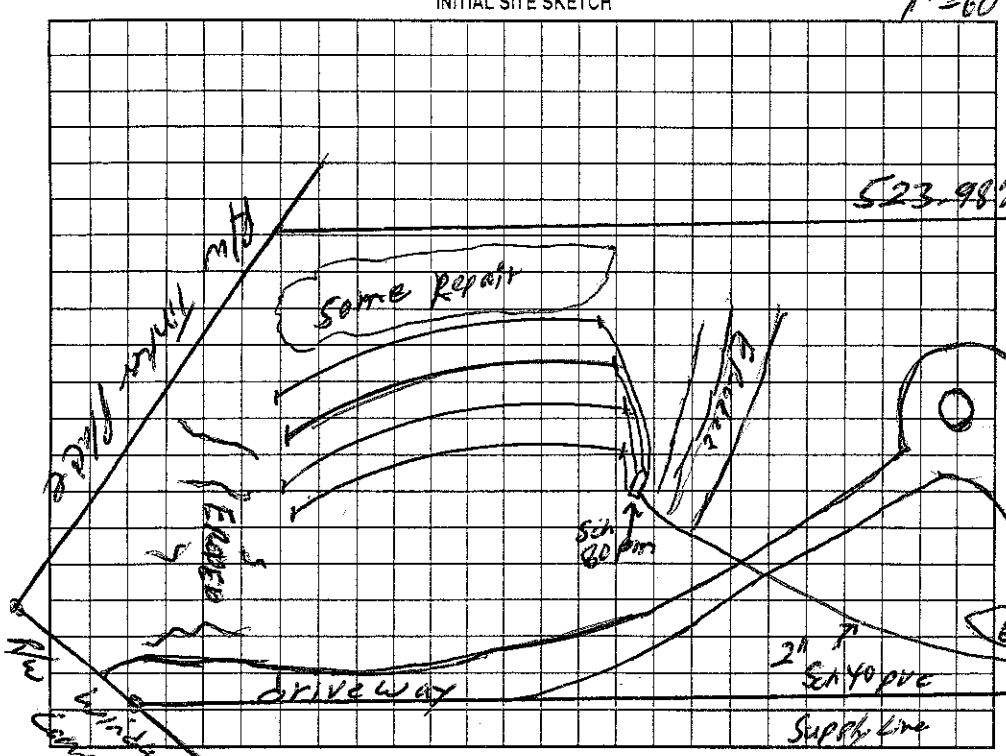

AS BUILT SKETCH

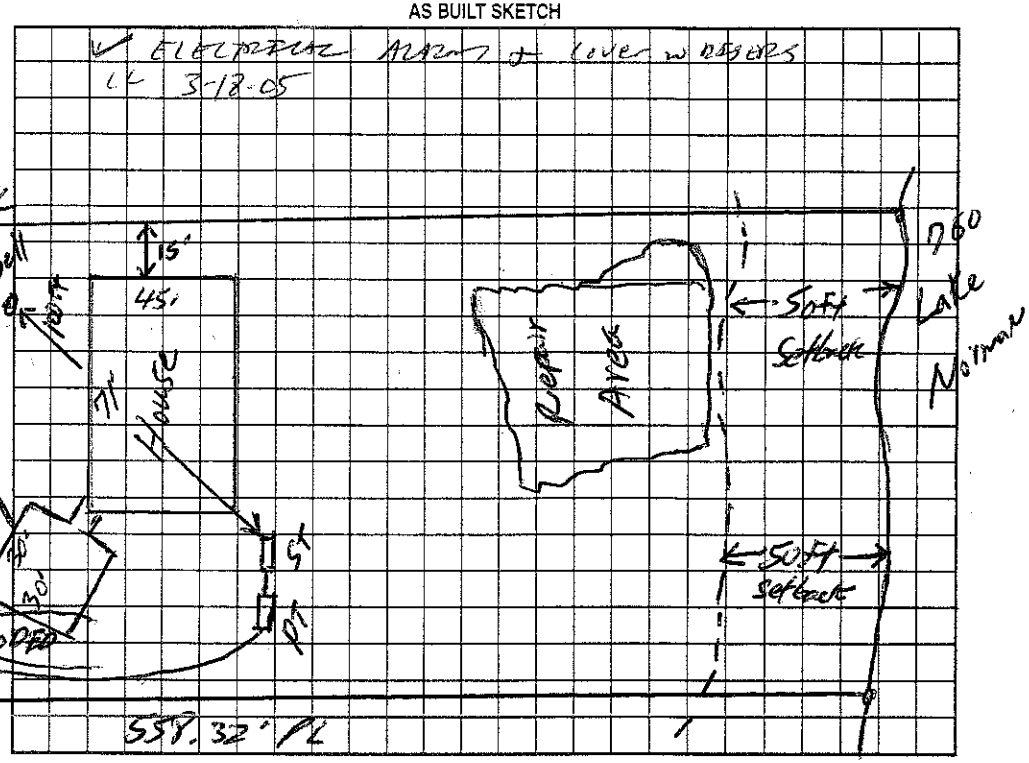

Permit can be suspended or revoked if any false information is supplied toward securing the permit/any unauthorized changes are made to the site/any unauthorized changes are made in the installation of the system. Improvement Permit with plat valid without expiration. Improvement Permit with site plan valid for sixty months. Authorization to Construct is valid for a period equal to that of Improvement Permit – not to exceed sixty months.

Signed: Stephen G Beck date 10-7-03 Installed by: JAMES HUSKER

Improvement Permit by: William O. Johnson date 9/8/03 Operation Permit by: PS date 3-18-05

Authorization to Construct by: William O. Johnson date 9/8/03 Existing System Inspection by: date

HEALTH DEPT. COPY: WHITE OWNER COPY (FINAL): YELLOW OWNER COPY (INITIAL): PINK

Permit expires 1/10/05.