IREDELL COUNTY HEALTH DEPARTMENT

STATESVILLE 704-878-5305 MOORESVILLE 704-664-5281

IMPROVEMENT PERMIT / AUTHORIZATION TO CONSTRUCT / OPERATION PERMIT / EXISTING SYSTEM INSPECTION

PERMIT# 086148 PIN# ~~4639-73-4457~~ 4629.53.0480 DATE 3-15-04

OWNER OR CONTRACTOR KEVIN HOSKINS PHONE: ~~Business~~ 704 528-5978 Cell ~~Home~~ 704-450-9250 wk 336-658-2478

ADDRESS 103 MASSEY ST TROUTMAN, NC 28166

LOCATION 21 SOUTH (R) PERTH (R) STATE PRK (L) MORRISON FARM (R) APRIL 4/10th mile LOT # 32 ON LEFT

SUBDIVISION HAWKES BAY BLOCK / SECTION ____ LOT 32 LOT AREA 44,850 sq ft SITE CLASS. PS DESIGN FLOW 480 L.T.A.R. .25

Septic Tank: 1000 Gallons; STB 160 Date 1-21-05
Pump Tank: 1000 Gallons; PT 319 Date 1-16-05
Pump Make: ~~Hydro~~ Model ~~HEO 712 HO~~ Serial No. 32 MOUSER
Nitrification Field: No Fields 1 Square Feet EQ=1920' Linear Feet 480
No Lines ~~6 x 80'~~ Trench Width ~~36"~~ 24" Max Trench Bottom Depth 36" Gravel Depth N/A

(X) New System ( ) Repair System Type: I, II, (III) IV, V, VI
System Description: ~~Pump 250 gal RED 50% RED~~ 50% RED
Repair System Description: LP PANEL / 50% REDUCT
Maintenance Agreement Required: ( ) Yes (X) No

(X) House/Mod. Home No. Bedrooms 4
( ) Mobile Home No. Bathrooms 2½
( ) Business No. Employees ____
( ) Other ____


( ) Slab ( ) Crawl Space ( ) Basement w/plumbing (X) Basement wo/plumbing

Water Supply: (X) Individual ( ) Public ( ) Community


Comments:/Conditions: (1) GRADE LOT SO SURFACE H_2O WILL FALL FROM FRONT OF HOME PAST GRADE TOWARD OLD ROAD CUT. THIS WILL MAINTAIN SETBACKS FOR POS DRAINAGE & TANKS SETBACKS. DRAWN AS ⇉ ON PERMIT (2) PERMIT REISSUED FROM ORIGINAL PERMIT; ONLY CHANGES WERE THE WELL LOCATION, HOUSE, & TANK LOCATIONS & PAD LOCATION.

Comments:/Conditions: (3) MAINTAIN SETBACKS & INSTALL LINES ON CONTOURS. (4) FOLLOW RULES WITH SUPPLY WHEN CROSSING UNDER THE DRIVE. (5) ANY BASEMENT PLUMBING WILL REQUIRE THE USE OF AN IN HOUSE PUMP TO LIFT TO MAIN LEVEL PLUMBING & THEN EXIT.

INITIAL SITE SKETCH

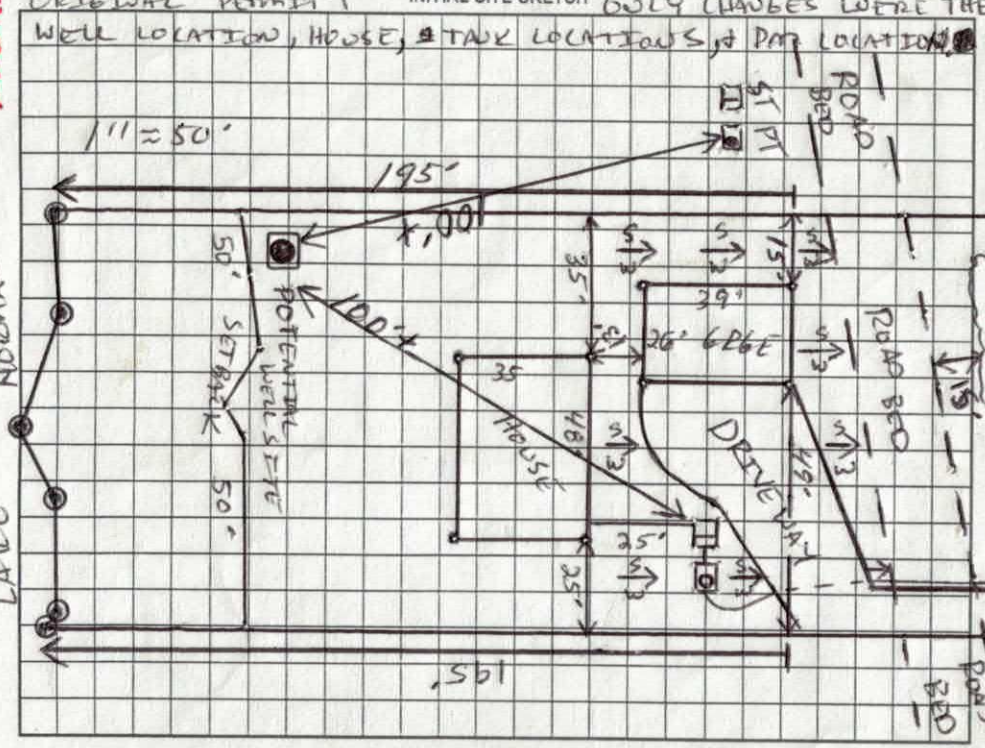

AS BUILT SKETCH POLYLOK FILTER & MARKER

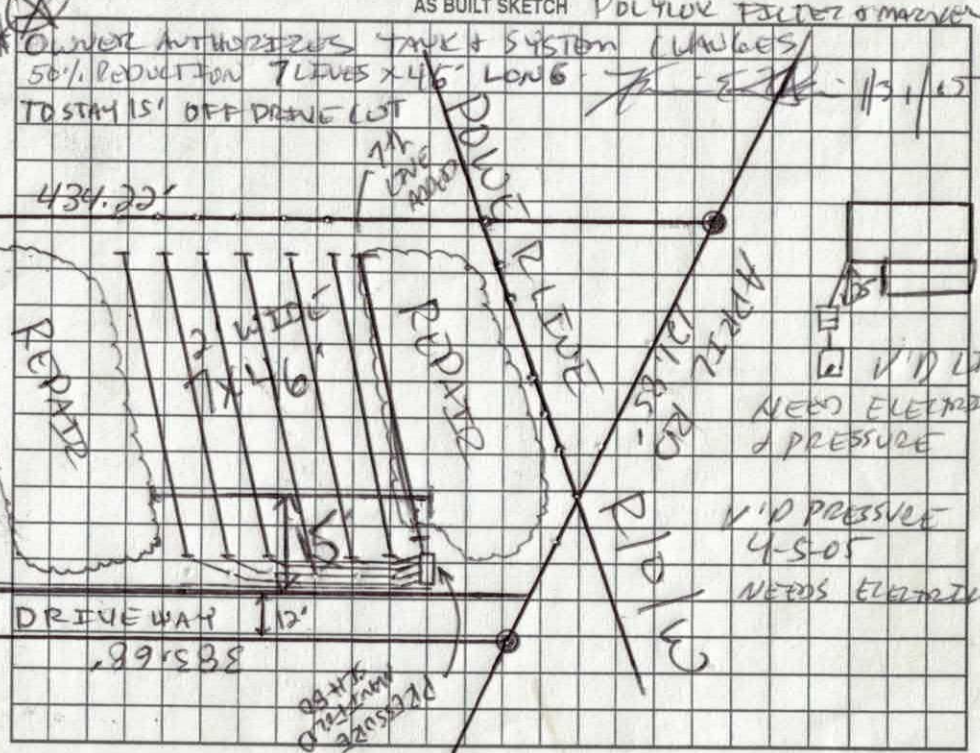

Permit can be suspended or revoked if any false information is supplied toward securing the permit/any unauthorized changes are made to the site/any unauthorized changes are made in the installation of the system. Improvement Permit with plat valid without expiration, Improvement Permit with site plan valid for sixty months. Authorization to Construct is valid for a period equal to that of Improvement Permit – not to exceed sixty months.

Signed: ____ date 3/16/04
Improvement Permit by: ____ date 3-15-04
Authorization to Construct by: ____ date 3-15-04

Installed by: LEATHERMAN SEPTIC
Operation Permit by: ____ date 7-14-11
Existing System Inspection by: ____ date ____

HEALTH DEPT. COPY: WHITE OWNER COPY (FINAL): YELLOW OWNER COPY (INITIAL): PINK

Lisa Address: 205 April Rd.

IREDELL COUNTY
PROPERTY DESCRIPTION FORM
P.O. BOX 788 277 S. CENTER ST.
STATESVILLE, NC 28687
Call Sanitarian Between
8 a.m. and 9 a.m.
664-5281 / 878-5305

Permit No: 086148 Zoning Permit: X Improvements Permit: 1

Name: CRESCENT RESOURCES Address: PO BOX 1003

City: CHARLOTTE State: NC Zip: 282010000

Phone: 7046636905

Proposed Use: 01

PIN #: 4639734457 PT Zoning: RA Township: 1700

Street Address: APRIL RD

Flood Zone: Plan Review Deposit: Date Received: / /

Subdivision/MHP: HAWKES BAY Lot #: 32 Lot Size: 44850

Has Property been recorded? N Community Water? Sewer?

Provider:

Watershed: WSIVCA Approximate Area to be Disturbed: 0

Total Built-upon Area: 0 Erosion Plan Required?

Setbacks: F35 S15 R50

Minimum Lot Size: 25000 Minimum Lot Width: 100

Land Use Permitted in this Zoning District? Y

Comments:

Hold Building Permits? Y Reason: PLAT NOT RECORDED

Location: ST PARK,L MORRISON FARM,R APRIL,7TH ON LEFT

Staff: RAM Date: 11/01/99

Fees: Zoning: $ 31.50 Health: $ 175.00

Signature of Applicant:_____
Owner: Agent:

ON-SITE WASTEWATER SECTION

COUNTY:

SOIL/SITE EVALUATION
for ON-SITE WASTEWATER SYSTEM

OWNER: CKJ APPLICANT:

ADDRESS: APPLICATION DATE: DATE EVALUATED: 11-16-99

PROPOSED FACILITY: PROPOSED DESIGN FLOW (.1949): PROPERTY SIZE:

LOCATION OF SITE: Lot 32 Hawkes Bay PROPERTY RECORDED:

WATER SUPPLY: ☐ Private ☐ Public ☐ Well ☐ Spring ☐ Other

EVALUATION METHOD: ☐ Auger Boring ☐ Pit ☐ Cut

TYPE OF WASTEWATER: ☐ Sewage ☐ Industrial Process ☐ Mixed

PROFILE #	.1940 LANDSCAPE POSITION/ SLOPE %	HORIZON DEPTH (IN.)	SOIL MORPHOLOGY (.1941) .1941 STRUCTURE/ TEXTURE	.1941 CONSISTENCE/ MINERALOGY	OTHER PROFILE FACTORS .1942 SOIL WETNESS/ COLOR	.1943 SOIL DEPTH	.1956 SAPRO CLASS	.1944 RESTR HORIZ	PROFILE CLASS & LTAR
1		0-9	gr hrn sl/scl fr						PS .25 -
		9-28	Sbk/pris RC	fi-vfi sp					
		28-59	massive hbrn/olbrn SL sap	few mi sap					.3+
2		0-4	hrn scL						PS .3
		4-23	mfsbk RC	fi sp					
		23-52	mvkfsbk cl	fr sss sp few mi sap					
		52-62	SL SAP						
3									
4									

DESCRIPTION	INITIAL SYSTEM	REPAIR SYSTEM
Available Space (.1945)		
System Type(s)		
Site LTAR		

OTHER FACTORS (.1946):

SITE CLASSIFICATION (.1948):

EVALUATED BY:

OTHER(S) PRESENT: