IREDELL COUNTY HEALTH DEPARTMENT

STATESVILLE 704-878-5305 (CV) MOORESVILLE 704-664-5281

IMPROVEMENT PERMIT / AUTHORIZATION TO CONSTRUCT / OPERATION PERMIT / EXISTING SYSTEM INSPECTION

PERMIT# 086073 PIN# 4639734457 (pt.) DATE Dec. 20, '99

OWNER OR CONTRACTOR Crescent Resources Inc. PHONE: Business Home

ADDRESS P.O. Box 1003 Charlotte

LOCATION State Park Rd. TR Morrison Farm Rd. TR April Lane on Right

SUBDIVISION Hawkins Bay BLOCK / SECTION LOT 19, 19A LOT AREA 60,590+ 20,247 sf SITE CLASS BSFE DESIGN FLOW 480 gpd L.T.A.R. ~.3

Septic Tank: 1000 Gallons: STB 1012 Date 8/17-01

Pump Tank: 1000 Gallons: PT 17 Date 2-9-01

Pump Make: Little Giant Model 145CIM Serial No. AJA04289

Nitrification Field: No Fields 1 Square Feet 200 Linear Feet 400

No Lines 4@150 Trench Width 36" Max Trench Bottom Depth 36" Gravel Depth N/A

☑ New System ☐ Repair System Type: I II III IV V VI

System Description: PM-Innoflow-25% Red on BSFE 19A

Repair System Description: LP Manifold Innoflow-25% Red ON BSFE 19A

Maintenance Agreement Required: ☐ Yes ☑ No

☑ House/Mod. Home ☐ Mobile Home ☐ Business ☐ Other

No. Bedrooms 4 No. Bathrooms 4 No. Employees


Water Supply: ☑ Individual ☐ Public ☐ Community

☐ Slab ☐ Crawl Space ☑ Basement w/plumbing ☐ Basement wo/plumbing


Comments/Conditions: *ONE INSpection for pond LATER. Maintain 100' from well on Lot 18 with septic tank & pump tank. MH

Comments/Conditions: - poly lok filter ST Marker Installed Inf/Meter Chambers Installed - 1/3/02

INITIAL SITE SKETCH

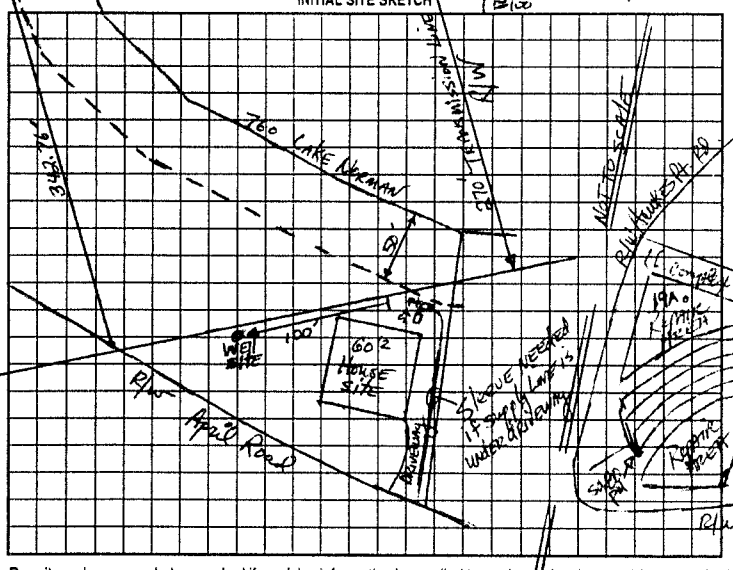

AS BUILT SKETCH

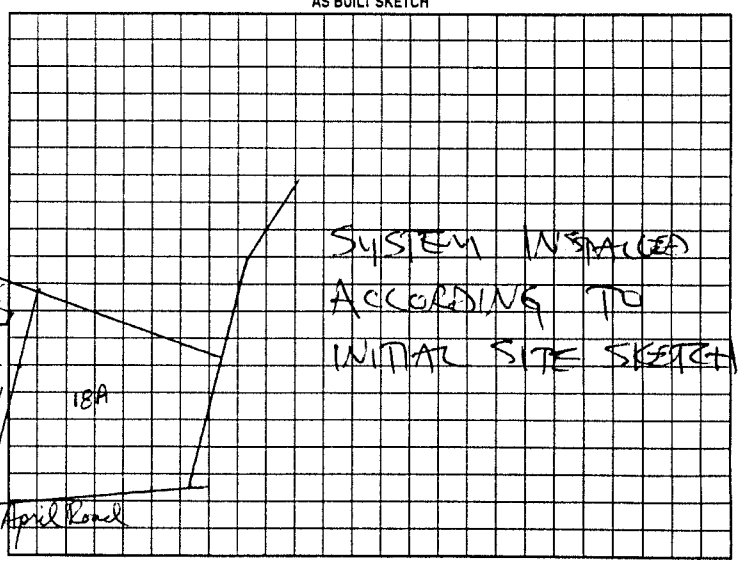

Permit can be suspended or revoked if any false information is supplied toward securing the permit/any unauthorized changes are made to the site/any unauthorized changes are made in the installation of the system. Improvement Permit with plat valid without expiration. Improvement Permit with site plan valid for sixty months. Authorization to Construct is valid for a period equal to that of Improvement Permit – not to exceed sixty months.

Signed: [signature] date 12-21-99 Installed by: Craig Thompson

Improvement Permit by: [signature], RS date 12-20-99 Operation Permit by: STEVE HEDRICK date 5-1-02

Authorization to Construct by: STEVE HEDRICK date 8-10-01 Existing System Inspection by: date

HEALTH DEPT. COPY: WHITE OWNER COPY (FINAL): YELLOW OWNER COPY (INITIAL): PINK