IREDELL COUNTY HEALTH DEPARTMENT

STATESVILLE 704-878-5305 MOORESVILLE 704-664-5281

IMPROVEMENT PERMIT / AUTHORIZATION TO CONSTRUCT / OPERATION PERMIT / EXISTING SYSTEM INSPECTION

(F

PERMIT# 086149 PIN# ~~4639-73-64457~~ 4629-53-2413 DATE 03-31-04

OWNER OR CONTRACTOR DICK McKEAN PHONE: Business 704-722-7370 Home 704-453-1375 / 704-361-3130

ADDRESS 633 BEAVER PATH MOORESVILLE, NC 28117

LOCATION STATE PARK RD SOUTH, (L) MORRISON FARM (R) APRIL (L) LOT # 33

SUBDIVISION HAWKS BAY BLOCK / SECTION ____ LOT 33 LOT AREA 1.14 AC SITE CLASS. PS DESIGN FLOW 480 L.T.A.R. .3

Septic Tank: 1000 Gallons; STB 1012 Date 10-1-03
Pump Tank: 1000 Gallons; PT 17 Date 10-2-03
Pump Make: GOULDS Model WE 1012-H Serial No. ~~[illegible]~~
Nitrification Field: No Fields 1 Square Feet EW=1600' Linear Feet 400' Ext 10-7-03
No Lines 8x50 Trench Width 36" Max Trench Bottom Depth 36" Gravel Depth N/A

☒ New System ☐ Repair System Type: I, II, (III), IV, V, VI
System Description: PUMP 25% REDUCT
Repair System Description: LP PANEL
Maintenance Agreement Required: ☐ Yes ☒ No

☒ House/Mod. Home No. Bedrooms 4
☐ Mobile Home No. Bathrooms 4
☐ Business No. Employees ____
☐ Other


☐ Slab ☐ Crawl Space ☒ Basement w/plumbing ☐ Basement wo/plumbing

Water Supply: ☒ Individual ☐ Public ☐ Community
WELL


Comments:/Conditions: (1) HOUSE & 50' SETBACK SURVEYED BY SURVEYOR (2) SYSTEM IS FLAGGED OUT COMPLETELY (3) THIS PERMIT REPLACES PREVIOUSLY ISSUED PERMIT DATED 05/01/03 (4) NEIGHBORING LOTS PERMITS WERE

Comments:/Conditions: PULLED TO DETERMINE SETBACKS. (5) MAINTAIN SETBACKS (6) HAD ENOUGH SOIL DEPTH TO GRADE OUT OLD ROAD BEDS AS DRAWN
JUFFTITE FILTER + MARKER

INITIAL SITE SKETCH

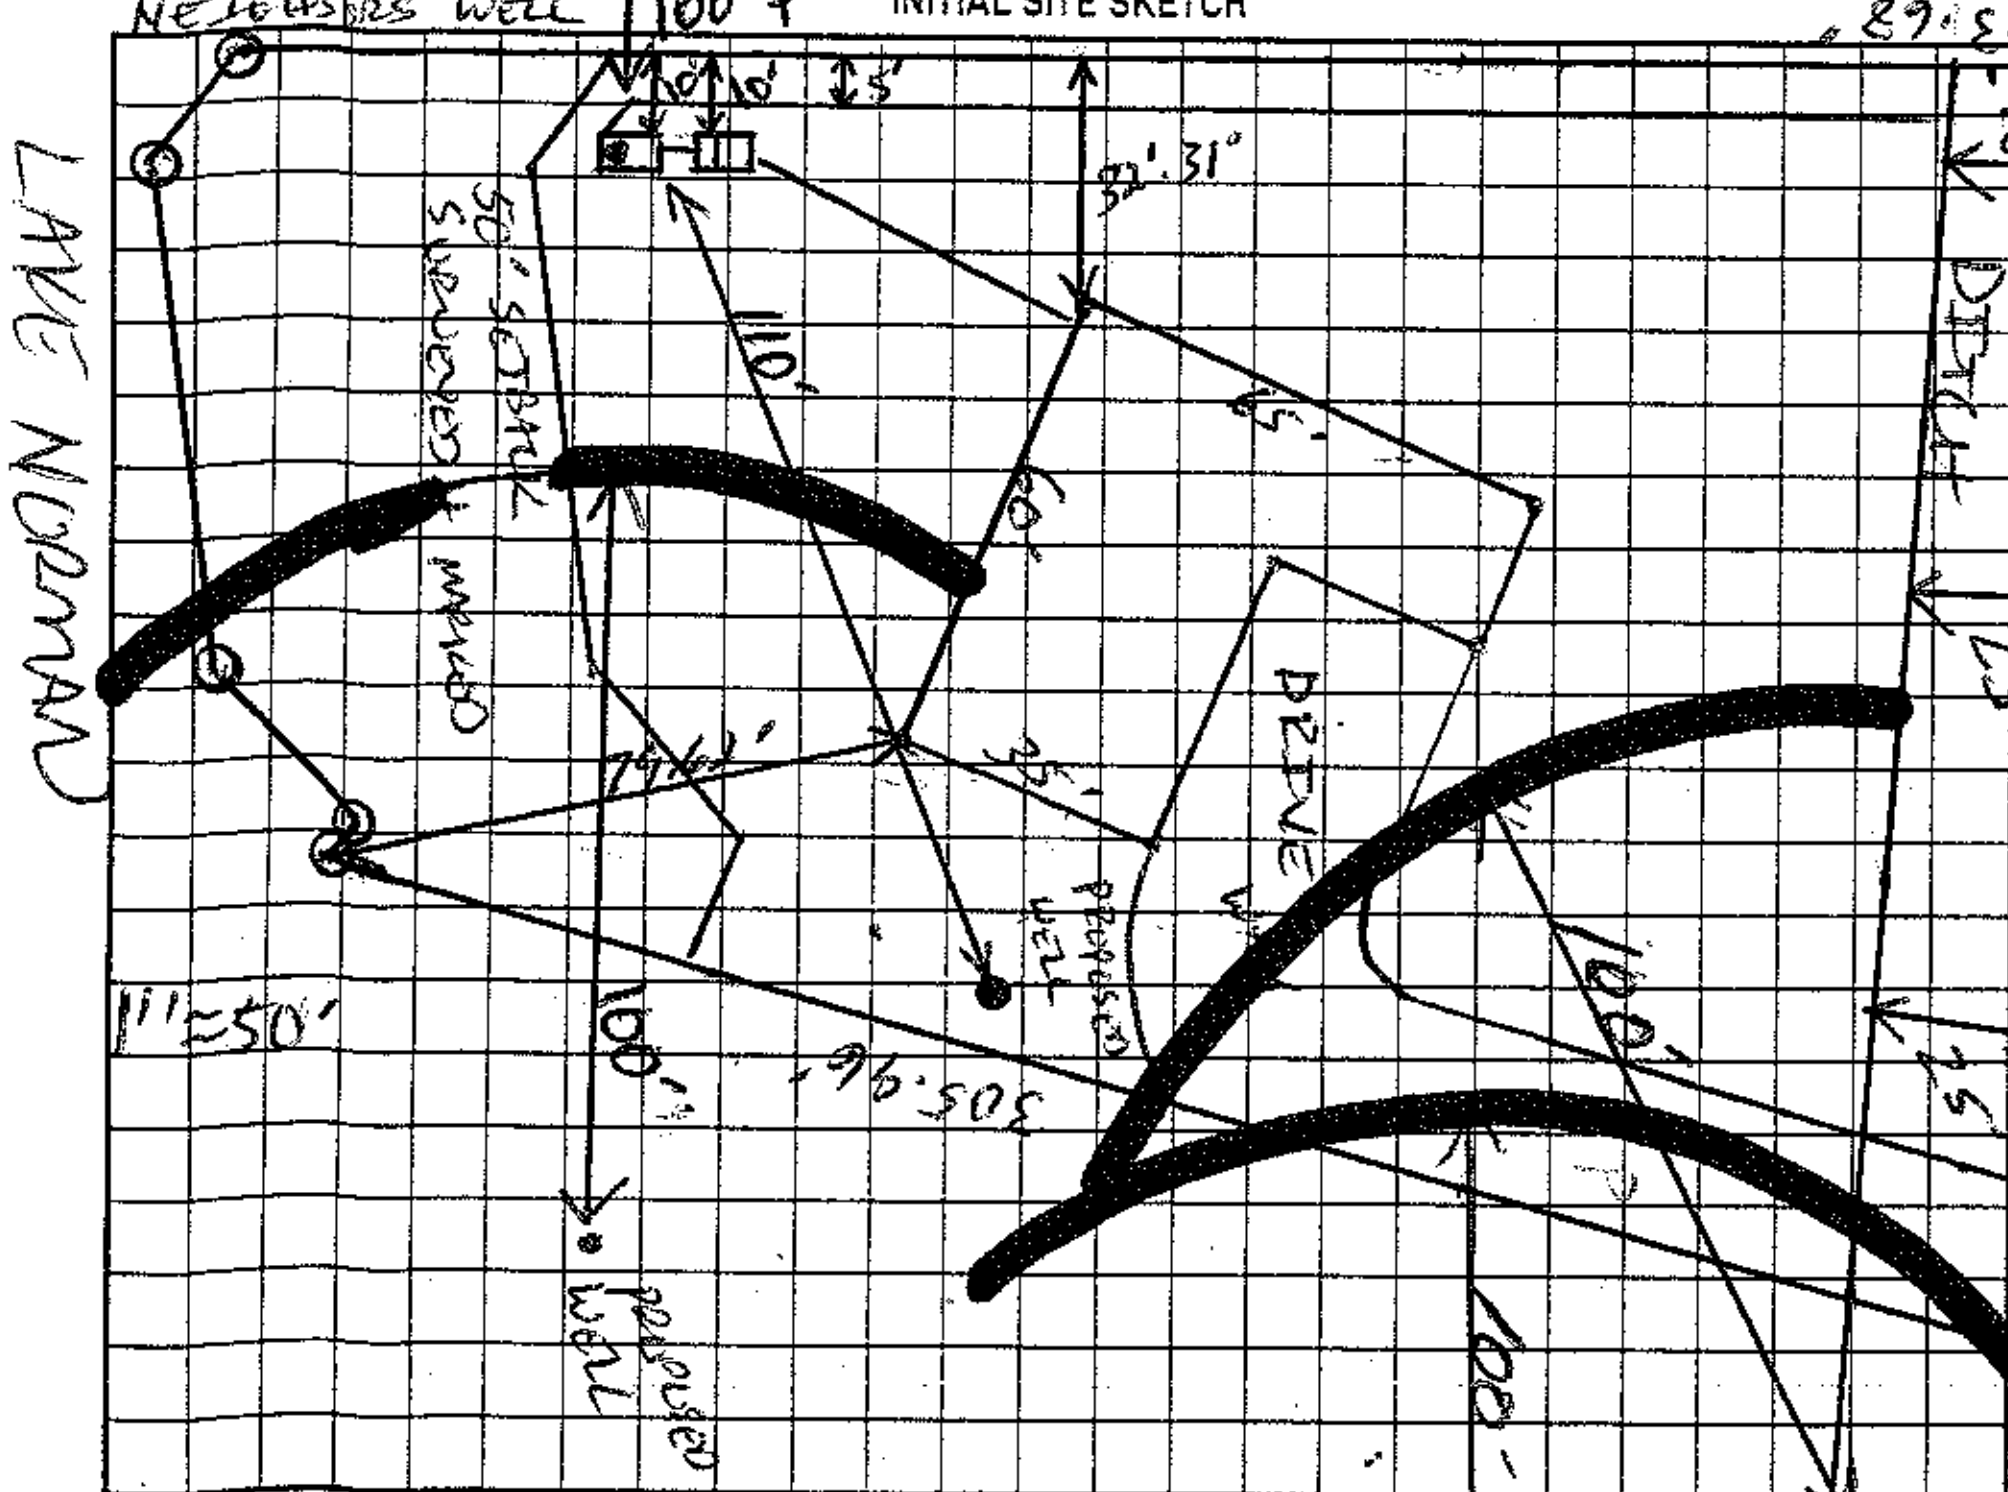

AS BUILT SKETCH

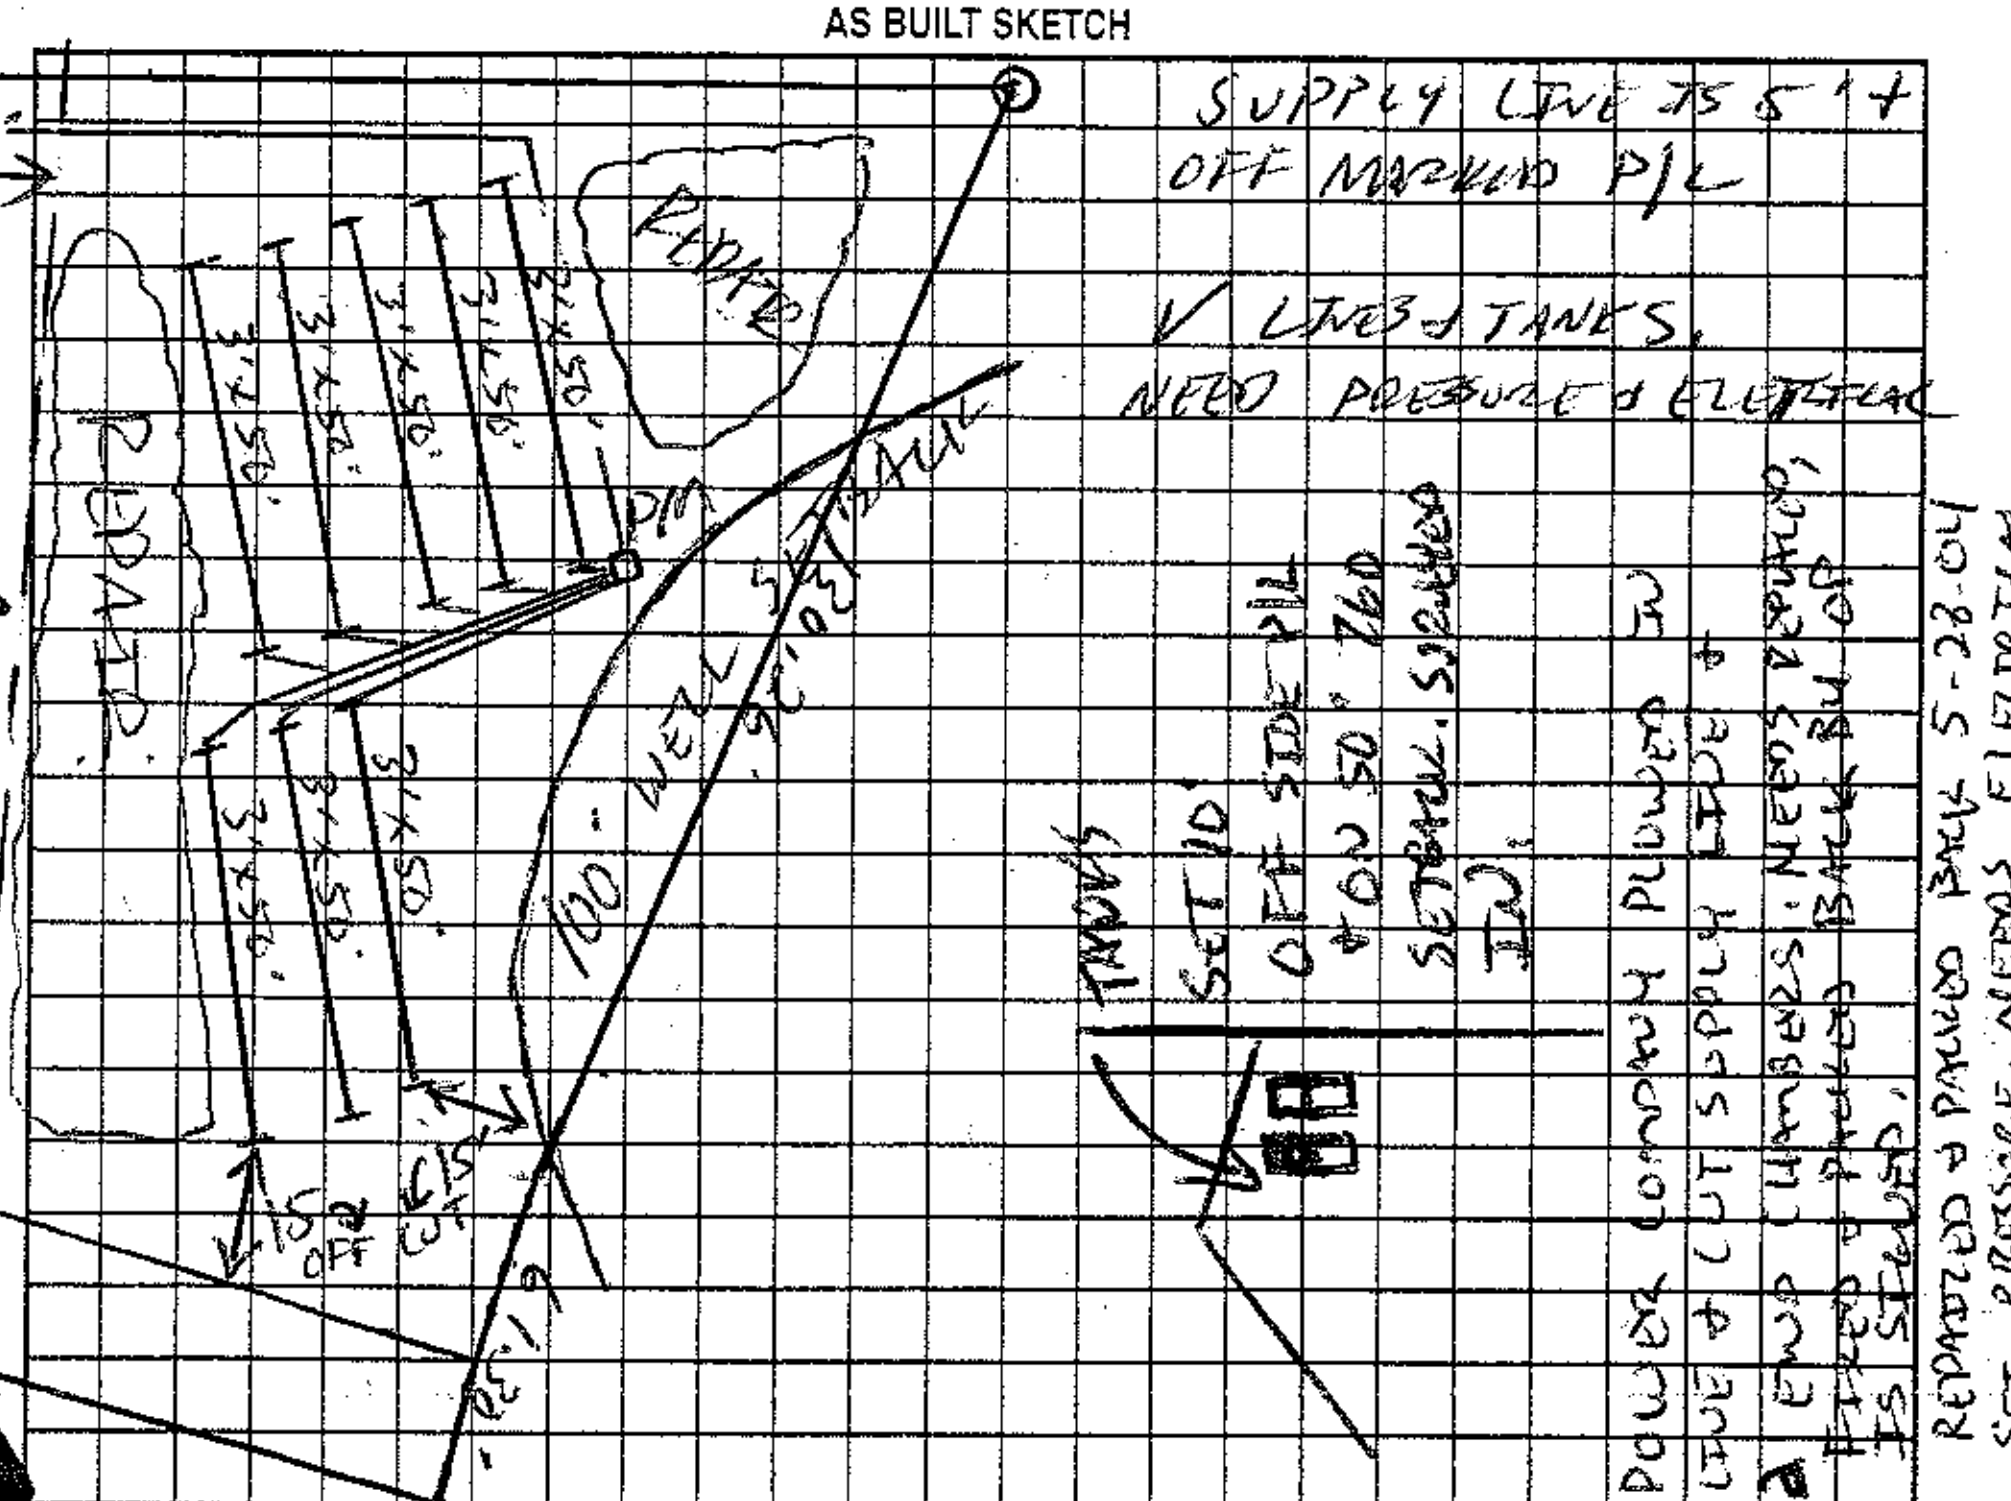

Permit can be suspended or revoked if any false information is supplied toward securing the permit/any unauthorized changes are made to the site/any unauthorized changes are made in the installation of the system. Improvement Permit with plat valid without expiration. Improvement Permit with site plan valid for sixty months. Authorization to Construct is valid for a period equal to that of Improvement Permit – not to exceed sixty months.

Signed: [signature] date ______ Installed by: A-1 BACKHOE

Improvement Permit by: [signature] RS date 3-31-04 Operation Permit by: [signature] RS date 6-11-04

Authorization to Construct by: [signature] RS date 3-31-04 Existing System Inspection by: ______ date ______

HEALTH DEPT. COPY: WHITE OWNER COPY (FINAL): YELLOW OWNER COPY (INITIAL): PINK