IREDELL COUNTY HEALTH DEPARTMENT

STATESVILLE 704-878-5305 CI MOORESVILLE 704-664-5281

IMPROVEMENT PERMIT / AUTHORIZATION TO CONSTRUCT / OPERATION PERMIT / EXISTING SYSTEM INSPECTION

PERMIT# 129606 PIN# 4629-53-3483 DATE 9-29-05

OWNER OR CONTRACTOR Atkinson Custom Homes PHONE: Business 704-506-9074 Home

ADDRESS 490 Rivercliff Lane Lexington, N.C. 27295

LOCATION Perth Rd (E) State Park (L) Morrison Farm (R) April Lot # 34 on Left

SUBDIVISION Hawks Bay BLOCK / SECTION I LOT 34 LOT AREA 1.145 AC SITE CLASS PS DESIGN FLOW 480 L.T.A.R. .3

Septic Tank: 1000 Gallons; STB 825 Date 4-1-06
Pump Tank: 1000 Gallons; PT 302 Date 3-4-06
Pump Make: Goulds Model PE51 Serial No.
Nitrification Field: No Fields 1 Square Feet ED=1600 Linear Feet 270'
No Lines 6x45' Trench Width 24" Max Trench Bottom Depth 36"

☒ New System ☐ Repair System Type: I, II, III, IV, V, VI
System Description: Pump Pressure manifold 50% Reduct
Repair System Description: LP 50% Reduct
Maintenance Agreement Required: ☐ Yes ☒ No
Gravel Depth N/A


☒ House/Mod. Home ☐ Mobile Home ☐ Business ☐ Other
No. Bedrooms 4 No. Bathrooms 4½ No. Employees
☐ Slab ☐ Crawl Space ☐ Basement w/plumbing ☒ Basement wo/plumbing

Water Supply: ☒ Individual ☐ Public ☐ Community


Comments:/Conditions: (1) KEEP HOUSE OUT OF GROUND & BACKFILL: IF POSITIVE DRAINAGE REQMTS ARE NEEDED: (2) INSTALL LINES ON CONTOURS & MAINTAIN SEPTICS. (3) OLD ROAD BED WAS LESS THAN 2' CUT. HAD ENOUGH SOIL DEPTH SO FT

Comments:/Conditions: WAS GRADED OUT. (4) CALL PRIOR TO INSTALLATION FOR PUMP SIZING & SYSTEM SPECS IF NECESSARY.

INITIAL SITE SKETCH 1" = 50'

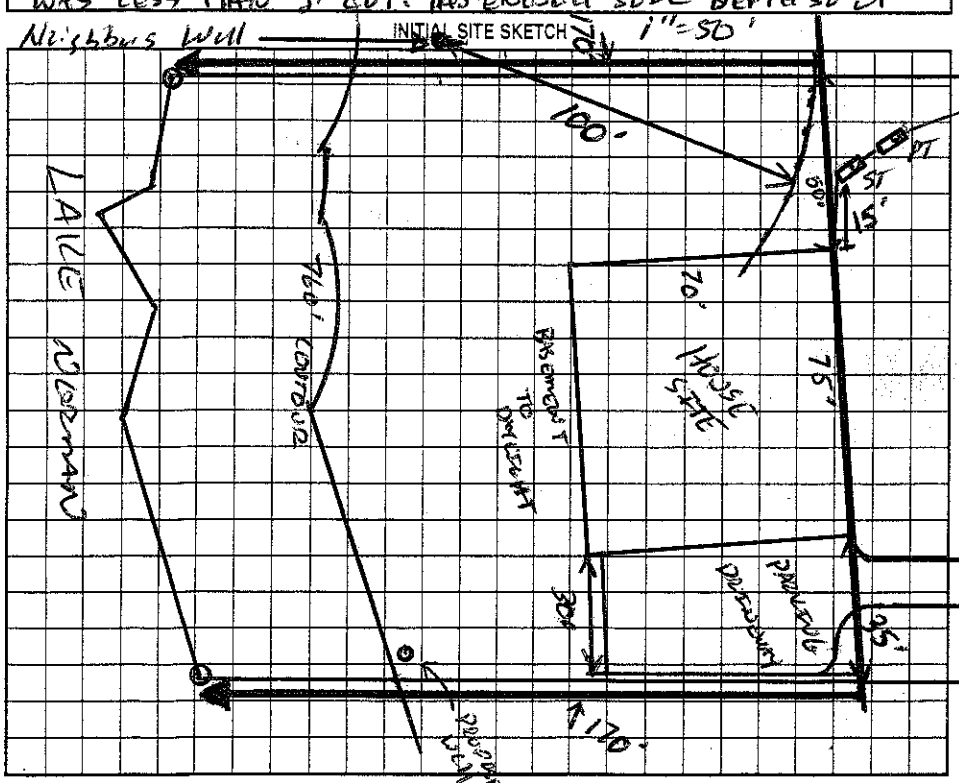

AS BUILT SKETCH

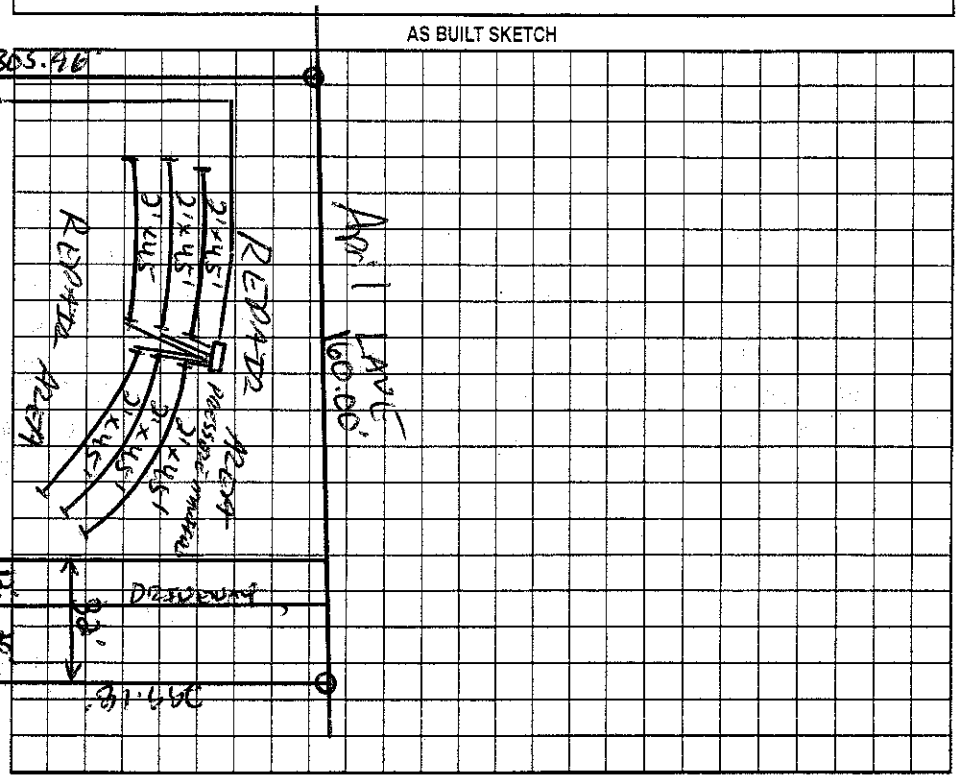

Permit can be suspended or revoked if any false information is supplied toward securing the permit/any unauthorized changes are made to the site/any unauthorized changes are made in the installation of the system. Improvement Permit with plat valid without expiration. Improvement Permit with site plan valid for sixty months. Authorization to Construct is valid for a period equal to that of Improvement Permit – not to exceed sixty months.

Signed: date 9-30-05 Installed by: Carolina Septic date 8-7-06

Improvement Permit by: date 9-29-05 Operation Permit by: date

Authorization to Construct by: date 9-29-05 Existing System Inspection by: date

HEALTH DEPT. COPY: WHITE OWNER COPY (FINAL): YELLOW OWNER COPY (INITIAL): PINK