CF // 664-8595 704 902-8134 Shannon 234.5 DOSE 325 gallons per ind per Alexander

IREDELL COUNTY HEALTH DEPARTMENT

STATESVILLE 704-878-5305 MOORESVILLE 704-664-5281

IMPROVEMENT PERMIT / AUTHORIZATION TO CONSTRUCT / OPERATION PERMIT / EXISTING SYSTEM INSPECTION

PERMIT# 14427 PIN# 4629535093 DATE 4-19-07

OWNER OR APPLICANT TIMOTHY LOMBARDI PHONE: Business 660-451-3107 Home BUS 704-363-9354

ADDRESS 4324 CANDLEWOOD DRIVE

LOCATION State Rte Rd ⓑ Morrison Dairy Rd ⓒ April ⓓ Windwood Lot # 41 on RT

SUBDIVISION HAMLET BAY BLOCK / SECTION LOT 41 LOT AREA 1.632 AC SITE CLASS. PS DESIGN FLOW 600 L.T.A.R. .3

Septic Tank: 1500 Gallons; STB 528 Date 10-29-07

Pump Tank: 1500 Gallons; PT 485 Date 9-26-06

Pump Make: Gould Model WU512 HNU Serial No.

Nitrification Field: No Fields 1 Square Feet EXP=2000 Linear Feet 500'

No Lines 3 SPLIT Trench Width 36" Max Trench Bottom Depth 36" Gravel Depth N/A ☐ Gravity ☒ Pressure

☒ New System ☐ Repair ☐ Expansion System Type: I II (III) IV V VI

System Description: PUMP 25% REDUCT

Repair System Description: LPD 50% REDUCT

Maintenance Agreement Required: ☐ Yes ☒ No

☒ House/Mod. Home ☐ Mobile Home ☐ Business ☐ Other

No. Bedrooms 5 No. Persons 10 No. Employees

Water Supply: ☒ Individual ☐ Public ☐ Community

☐ Slab ☐ Crawl Space ☒ Basement w/plumbing ☐ Basement wo/plumbing

Comments:/Conditions: ① Keep House Out of Ground & BACKFILL For Positive Drainage REQMTS, ② CALL PRIOR TO INSTALLATION for System Specs if NECESSARY,

Comments:/Conditions: FILTER INSTALLED

INITIAL SITE SKETCH

SEE ATTACHED SYSTEM DESIGN BY LORNE COOK, P.E.

AS BUILT SKETCH

Permit can be suspended or revoked if any false information is supplied toward securing the permit/any unauthorized changes are made to the site/any unauthorized changes are made in the installation of the system. Improvement Permit with plat valid without expiration ☐ Improvement Permit with site plan valid for sixty months ☒ Authorization to Construct is valid for a period equal to that of Improvement Permit – not to exceed sixty months.

Signed: date 4-20-2007 Installed by: C & S Grading

Improvement Permit by: date 4-19-07 Operation Permit by: date 4-9-08

Authorization to Construct by: date 4-19-07 Existing System Inspection by: date

HEALTH DEPT. COPY: WHITE OWNER COPY (FINAL): YELLOW OWNER COPY (INITIAL): PINK


Permit # 141427
Pin #4629535093

I, RUFUS JACKSON LOVE CERTIFY THAT THIS MAP WAS DRAWN FROM ACTUAL SURVEY UNDER MY DIRECT SUPERVISION, THAT THE RATIO OF PRECISION IS 1:10,000+ BEFORE ADJUSTMENTS; AND THAT THE ANGULAR ERROR WAS < 7.5 SECONDS PER TURN.

WITNESS MY HAND AND OFFICIAL SEAL THIS _____ DAY OF _____

PRELIMINARY
NOT FOR SALES, CONVEYANCES OR RECORDATION
PROFESSIONAL LAND SURVEYOR

VICINITY MAP
NO SCALE

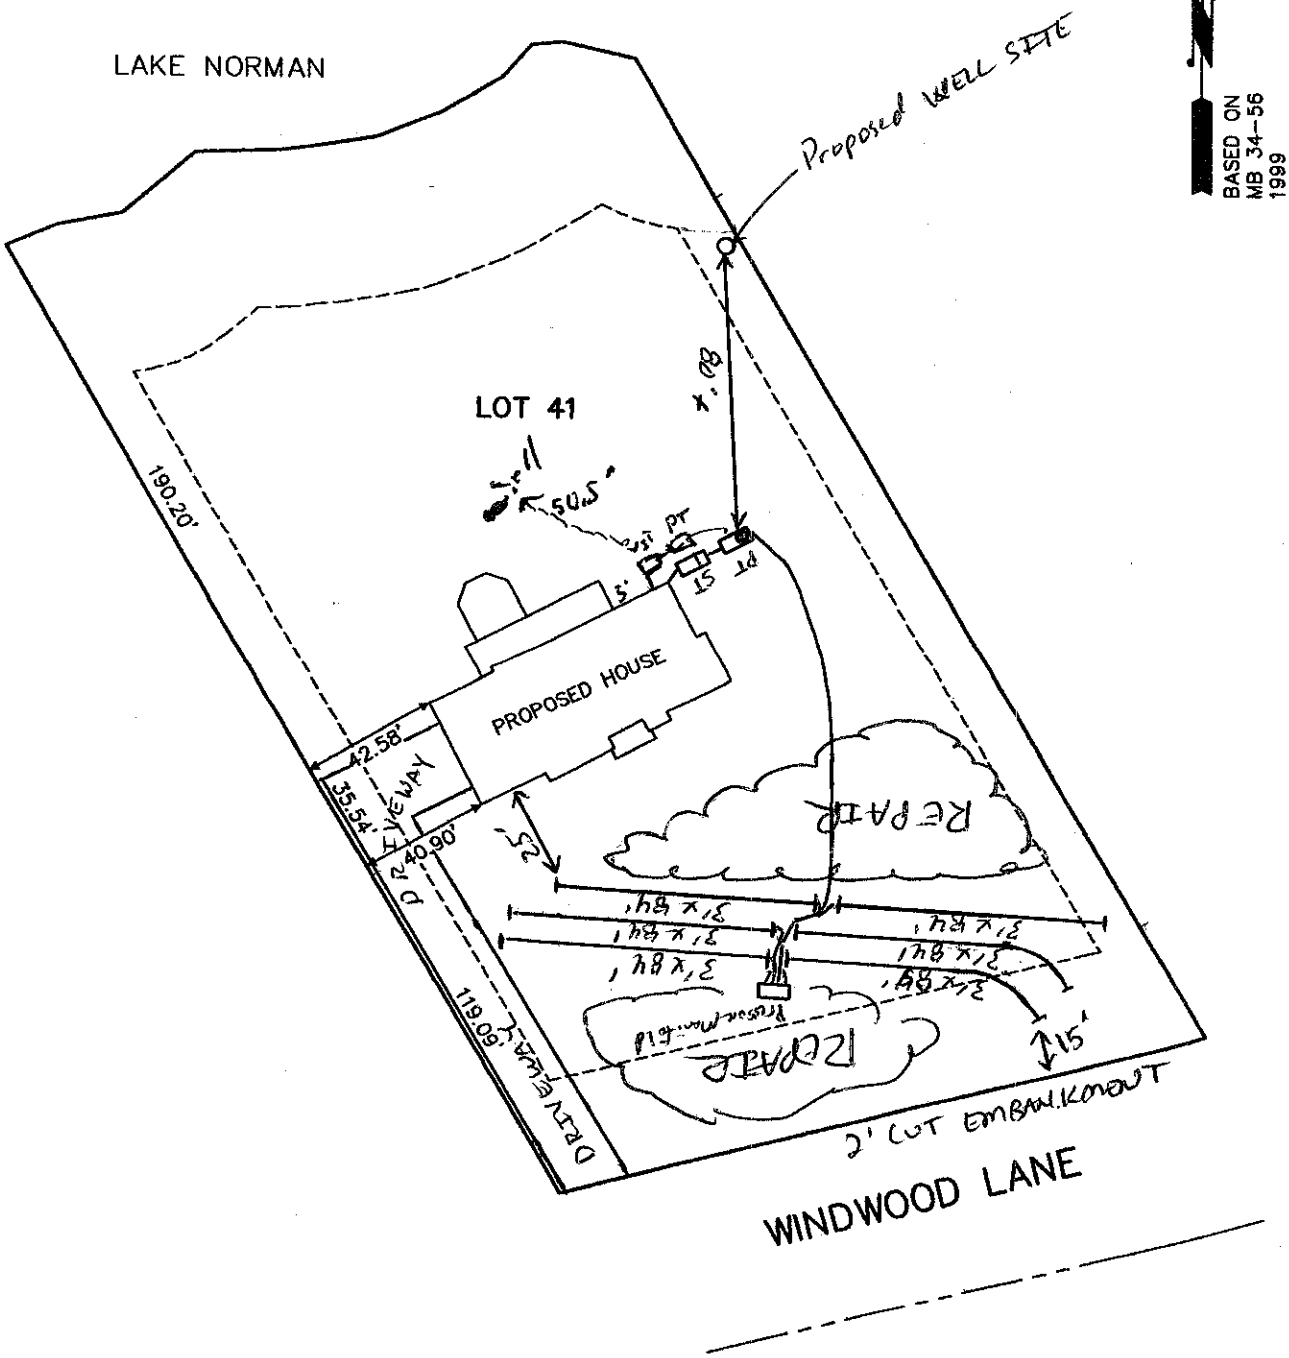

BOUNDARY/PHYSICAL SURVEY
FOR JUSTMOR HOMES
PROPERTY OF TIMOTHY A. LOMBARDI & wf., REBECCA
160 WINDWOOD LANE
LOT 41 OF HAWKES BAY, MB 34 PG 56

NOTES:

1. THIS PROPERTY IS NOT LOCATED IN A DESIGNATED FLOOD ZONE.
2. AREA DETERMINED BY COORDINATE COMPUTATION.
3. CP DENOTES COMPUTED POINT, NO MONUMENT FOUND OR SET.
4. UNDERGROUND UTILITIES NOT LOCATED AS OF THIS DATE.
5. NO GRID MONUMENTS APPEAR TO BE WITHIN 2000'.