DELL COUNTY HEALTH DEPARTMENT

STATESVILLE 704-878-5305 MOORESVILLE 704-664-5281

IMPROVEMENT PERMIT / AUTHORIZATION TO CONSTRUCT / OPERATION PERMIT / EXISTING SYSTEM INSPECTION

PERMIT# 1309427 PIN# 4629535971 / 4629-54-8072 DATE 9-7-05

OWNER OR CONTRACTOR Tamra McNeill PHONE: Business 704-677-2881 Home 704-322-4232

ADDRESS 159 Walnut Ln Unit Mooresville NC 28117

LOCATION State park RD to Marion Farms RD to April LN to Hawks Ct Drive Lot on left SPE on right

SUBDIVISION Lakesburg BLOCK / SECTION ____ LOT 16, 16A LOT AREA 20.02ac ± 271308f SITE CLASS 23 DESIGN FLOW 480 L.T.A.R. 425

Septic Tank: 1000 Gallons; STB 1000 Date 5-2-05
Pump Tank: 1000 Gallons; PT 374 Date 4-10-05
Pump Make: ____ Model Ie-44-511 Serial No. ____
Nitrification Field: No Fields ____ Square Feet 990 Linear Feet 330
No Lines 3 Trench Width 36" Max Trench Bottom Depth 36" Gravel Depth NA


☑ New System ☐ Repair System Type: I, II, III, IV, V, VI
System Description: Pfanel Block
Repair System Description: same
Maintenance Agreement Required: ☑ Yes ☐ No

☑ House/Mod. Home ☐ Mobile Home ☐ Business ☐ Other
No. Bedrooms 4 No. Bathrooms 4 No. Employees ____
☐ Slab ☐ Crawl Space ☑ Basement w/plumbing ☐ Basement wo/plumbing

Water Supply: ☑ Individual ☐ Public ☐ Community


Comments/Conditions: Maintain all set backs
Install on Contour
Pump - 90 amps
4" sewage

INITIAL SITE SKETCH

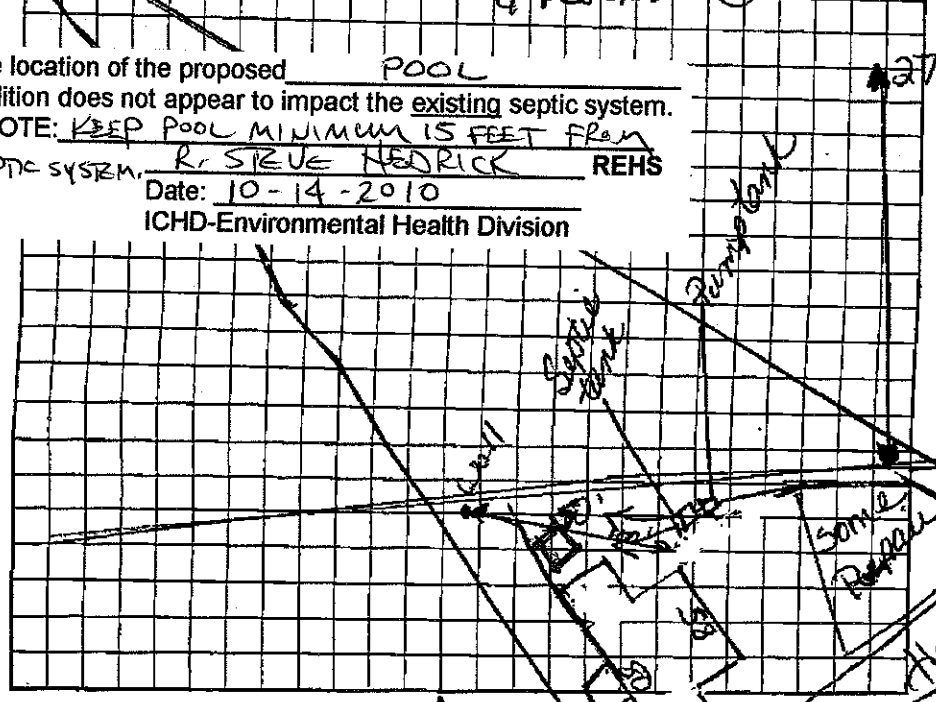

Comments/Conditions: 12-12-05 - Checked soil
Lines within 50' -
Add them to ductile iron water
supply line within 25'
septic tank and pump tank

AS BUILT SKETCH

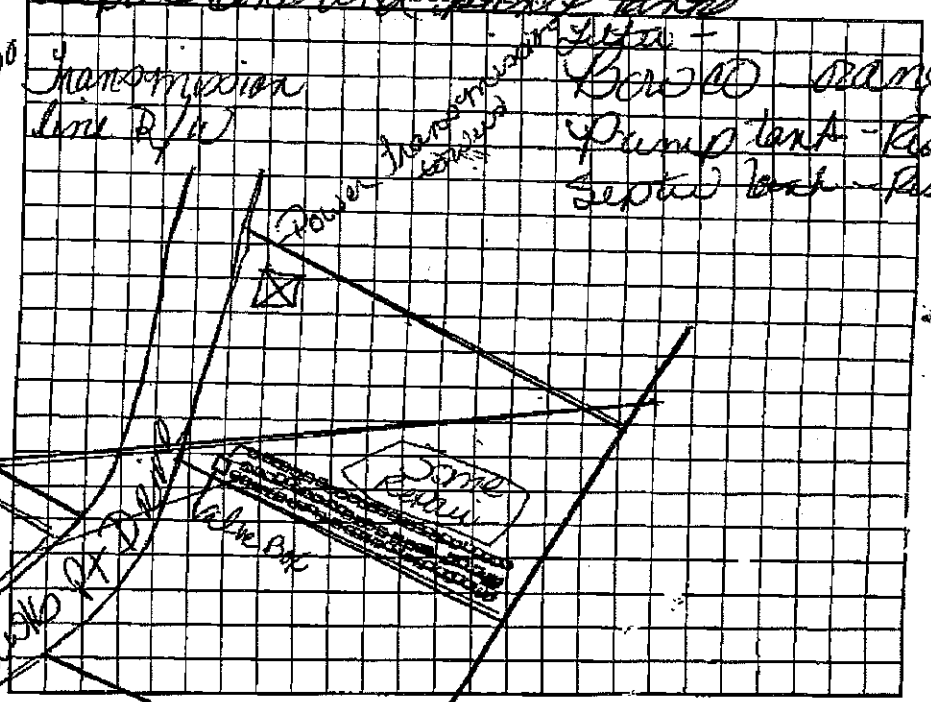

The location of the proposed POOL addition does not appear to impact the existing septic system.
**NOTE: KEEP POOL MINIMUM 15 FEET FROM SEPTIC SYSTEM.
R. STEVE HEDRICK REHS
Date: 10-14-2010
ICHD-Environmental Health Division

Permit can be suspended or revoked if any false information is supplied towards the permit/any unauthorized changes are made to the site/any unauthorized changes are made in the installation of the system. Improvement Permit with plat valid without expiration. Improvement Permit with site plan valid for sixty months. Authorization to Construct is valid for a period equal to that of Improvement Permit – not to exceed sixty months.

Signed: [signature] 9/15/05 date 9/15/05 Installed by: Abernathy
Improvement Permit by: [signature] date 9-13-05 Operation Permit by: [signature] date 10-20-05
Authorization to Construct by: [signature] date 9-13-05 Existing System Inspection by: ____ date ____

HEALTH DEPT. COPY: WHITE OWNER COPY (FINAL): YELLOW OWNER COPY (INITIAL): P

16 3810

163810