IREDELL COUNTY HEALTH DEPARTMENT

126138

STATESVILLE 704-878-5305 CI MOORESVILLE 704-664-5281

IMPROVEMENT PERMIT / AUTHORIZATION TO CONSTRUCT / OPERATION PERMIT / EXISTING SYSTEM INSPECTION

PERMIT# ~~086152~~ / 126138 PIN# ~~4634 73 4457~~ 29536455 DATE 3/8/05

OWNER OR CONTRACTOR Jim Purvis PHONE: Business 704-902-5624 Home

ADDRESS 109 Redbud Ln. Troutman NC 28166

LOCATION State Pk Rd TL Morrison Farm, TR April, on lt

SUBDIVISION Hawkes Bay BLOCK / SECTION LOT 36 LOT AREA 33,547 Ft² SITE CLASS. PS DESIGN FLOW 360 L.T.A.R. 0.3

Septic Tank: 1000 Gallons; STB 1012 Date 9-7-05
Pump Tank: Gallons; PT Date
Pump Make: Model Serial No.
Nitrification Field: No Fields 1 Square Feet 900 Linear Feet 300
No Lines 4 Trench Width 36" Max Trench Bottom Depth 36" Gravel Depth —

☒ New System ☐ Repair System Type: I, II, III, IV, V, VI
System Description: Gravity 25% Reduct.
Repair System Description: Same
Maintenance Agreement Required: ☐ Yes ☒ No

☒ House/Mod. Home No. Bedrooms 3
☐ Mobile Home No. Bathrooms
☐ Business No. Employees
☐ Other


☐ Slab ☐ Crawl Space ☒ Basement w/plumbing ☐ Basement wo/plumbing

Water Supply: ☒ Individual ☐ Public ☐ Community


Comments/Conditions: 1" = 50'

Comments/Conditions: TUFFETTE Filter & MARKER

INITIAL SITE SKETCH

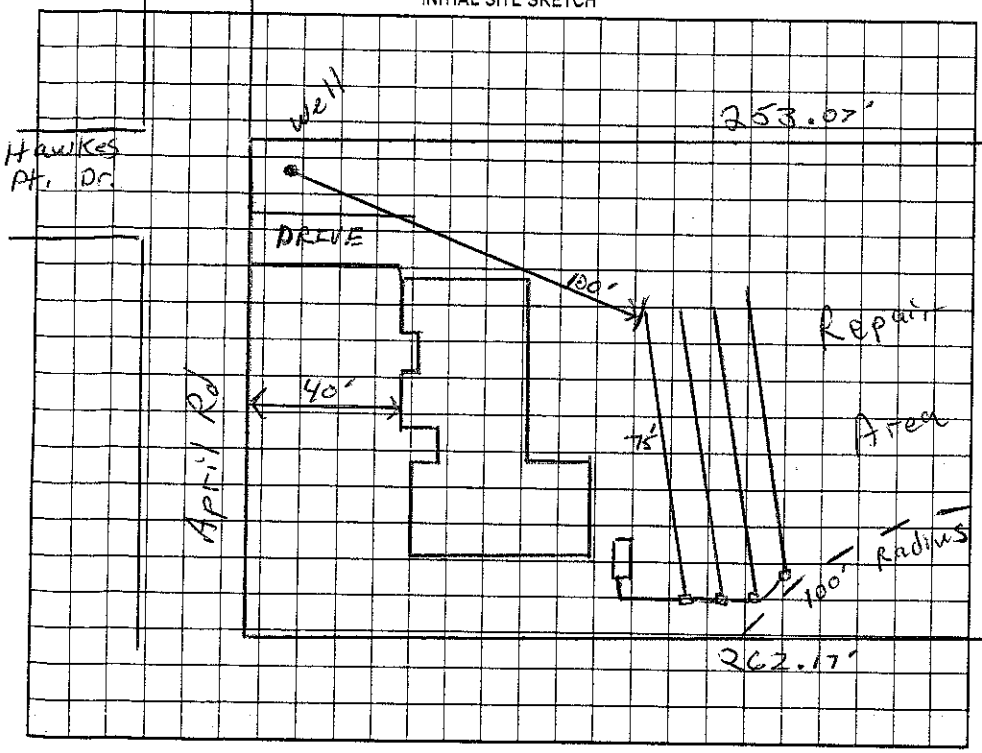

AS BUILT SKETCH

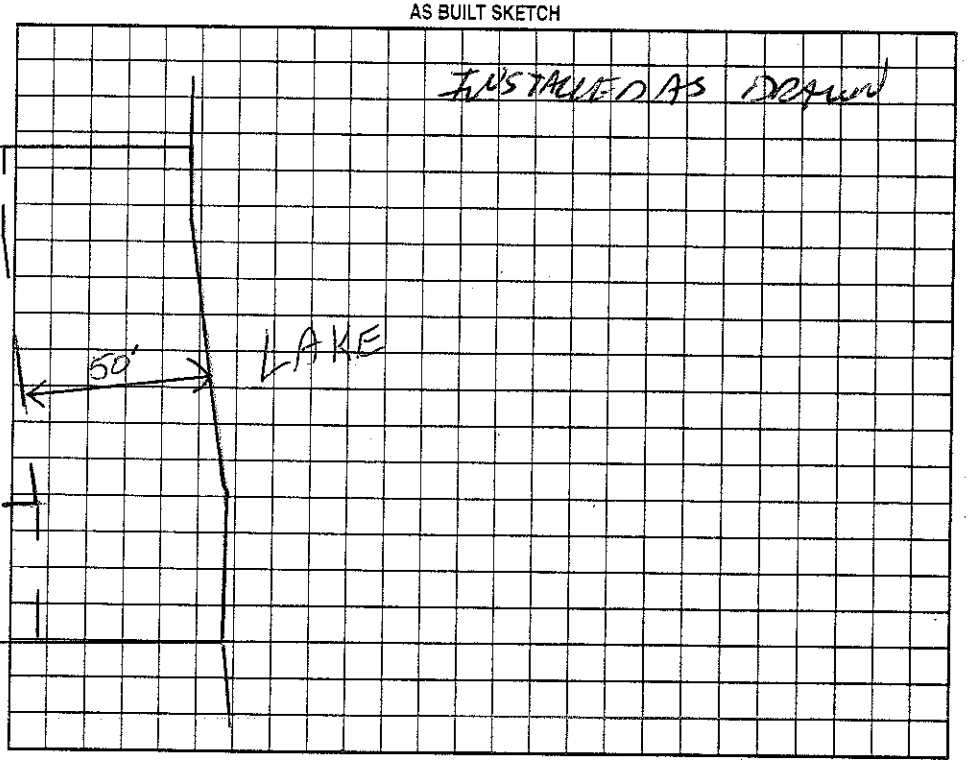

Permit can be suspended or revoked if any false information is supplied toward securing the permit/any unauthorized changes are made to the site/any unauthorized changes are made in the installation of the system. Improvement Permit with plat valid without expiration. Improvement Permit with site plan valid for sixty months. Authorization to Construct is valid for a period equal to that of Improvement Permit – not to exceed sixty months.

Signed: Millard Brasington date 4-11-05 Installed by: Steve Jarrett

Improvement Permit by: RS date 3/8/05 Operation Permit by: RS date 10-21-05

Authorization to Construct by: RS date 3/8/05 Existing System Inspection by: date

HEALTH DEPT. COPY: WHITE OWNER COPY (FINAL): YELLOW OWNER COPY (INITIAL): PINK