IREDELL COUNTY HEALTH DEPARTMENT

STATESVILLE 704-878-5305 MOORESVILLE 704-664-5281

IMPROVEMENT PERMIT / AUTHORIZATION TO CONSTRUCT / OPERATION PERMIT / EXISTING SYSTEM INSPECTION

PERMIT# 086067 PIN# ~~4639934457 (pt)~~ 4629-54-5598 DATE Jan. 12, 2000

OWNER OR CONTRACTOR Crescent Resources Inc PHONE: Business _____ Home _____

ADDRESS P.O. Box 1003 Charlotte

LOCATION State Park Road TL Morrison Farm Rd. TR April Rd. (SFE#5 - 12A on Right) TR Hawkes Pt. Drive 6th 12 at end

SUBDIVISION Hawkes Bay BLOCK / SECTION _____ LOT 12/12A LOT AREA 34,433 + 21,645 ft² SITE CLASS PS SFE DESIGN FLOW 480 gpd L.T.A.R. .25+ SFE 12A/5

Septic Tank: 1000 Gallons; STB 312 Date 02/10/03
Pump Tank: 1000 Gallons; PT 27 Date 03/08/03
Pump Make: ZOELLER Model N161 Serial No. 1.5 HP
Nitrification Field: No Fields 1 Square Feet 1500 Linear Feet 500
No Lines 4@125' Trench Width 36" Max Trench Bottom Depth 36"

☑ New System ☐ Repair System Type: I, II, III, IV, V, VI
System Description: PM - INNOVATIVE - 25% Reduction
Repair System Description: LP Panel Block
Maintenance Agreement Required: ☐ Yes ☑ No initially
Gravel Depth NA

☑ House/Mod. Home No. Bedrooms 4
☐ Mobile Home No. Bathrooms 4
☐ Business No. Employees _____
☐ Other _____
☐ Slab ☐ Crawl Space ☑ Basement w/plumbing ☐ Basement wo/plumbing


Water Supply: ☑ Individual ☐ Public ☐ Community

Comments:/Conditions: ONE INSPECTION port PER LATERAL


760 LAKE NORMAN

Comments:/Conditions: Home To be Relocated back To 50ft Setback Tanks may be positiond in The Front of the Home And placed To insure GRAVITY Fall From home. Call 928-2030 To locate Tanks when Ready

INITIAL SITE SKETCH 1"=50'

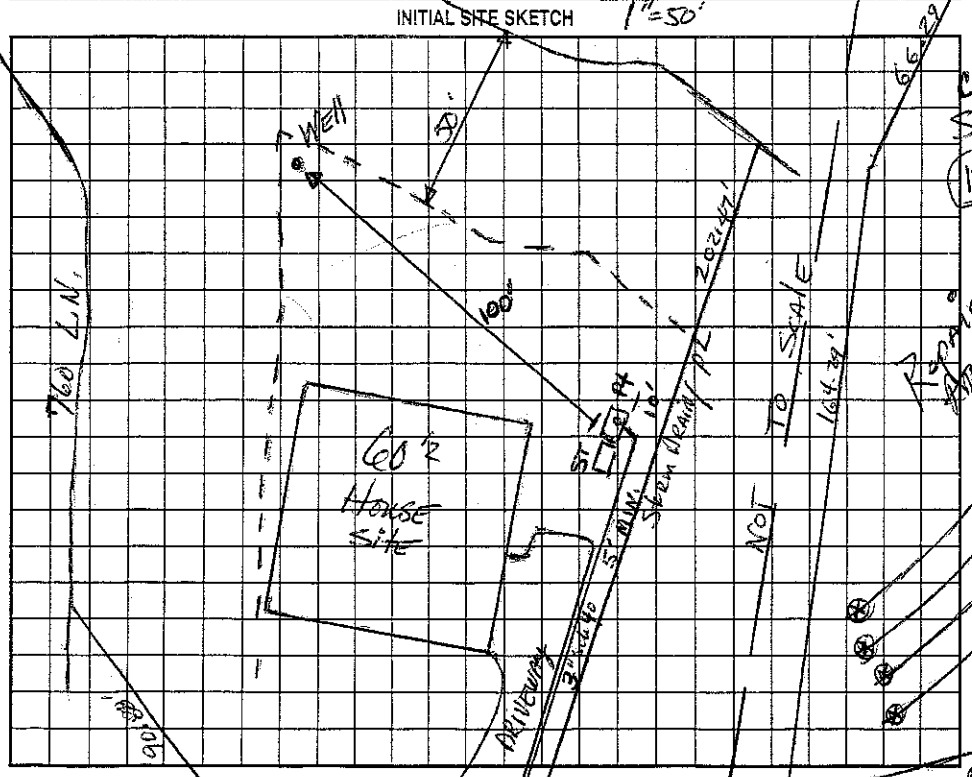

AS BUILT SKETCH

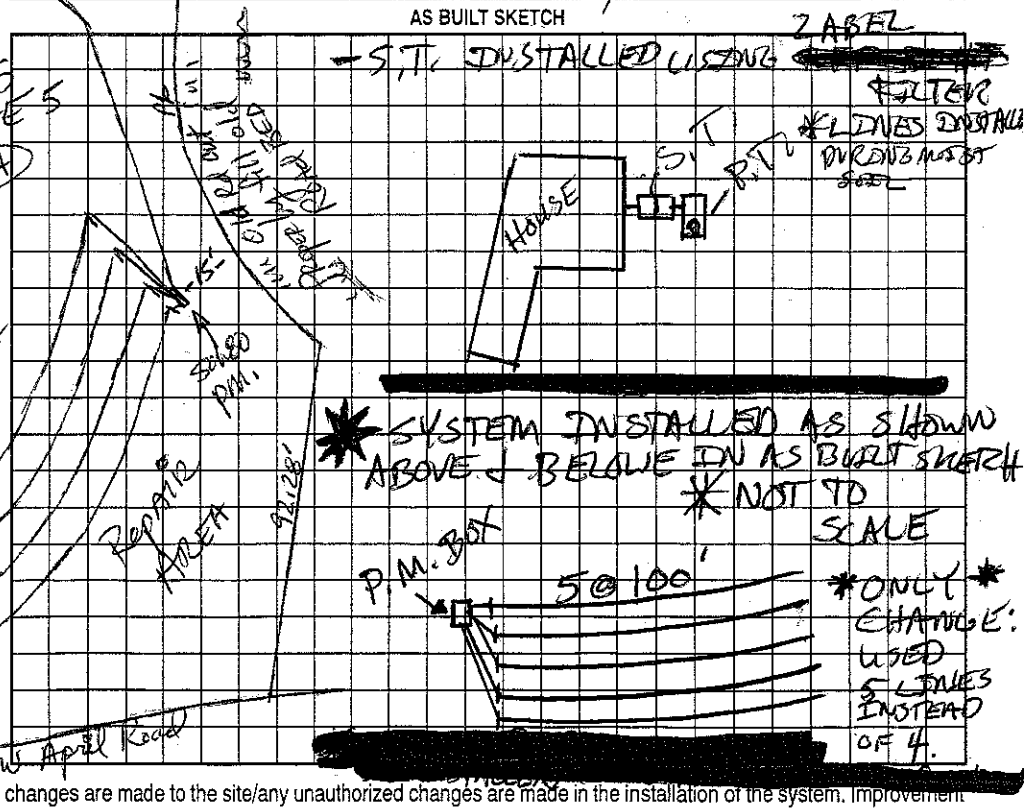

Permit can be suspended or revoked if any false information is supplied toward securing the permit/any unauthorized changes are made to the site/any unauthorized changes are made in the installation of the system. Improvement Permit with plat valid without expiration. Improvement Permit with site plan valid for sixty months. Authorization to Construct is valid for a period equal to that of Improvement Permit – not to exceed sixty months.

Signed: _____ date 1-14-00 Installed by: RUSSELS WELL (TANKS 4-24-03) (LINES 05/09/03)

Improvement Permit by: _____ date Jan 12, 2000 Operation Permit by: Patrick Mitchell date 05/13/03

Authorization to Construct by: _____ date May 1 2000 Existing System Inspection by: _____ date _____

HEALTH DEPT. COPY: WHITE OWNER COPY (FINAL): YELLOW OWNER COPY (INITIAL): PINK