This Permit void previously issued permit dated 1/12/00.

IREDELL COUNTY HEALTH DEPARTMENT

STATESVILLE 704-878-5305 MOORESVILLE 704-664-5281

IMPROVEMENT PERMIT / AUTHORIZATION TO CONSTRUCT / OPERATION PERMIT / EXISTING SYSTEM INSPECTION

PERMIT# 086066 PIN# 4639734457 (A) DATE March 15, 2002

OWNER OR CONTRACTOR Crescent Resources, Inc. / Warren Smith PHONE Business (704) 363-1622 Home —

ADDRESS P.O. Box 1003 Charlotte, N.C.

LOCATION State Park Rd, (L) Morrison Farm Road, (R) April Road, (R) Hawkes Pt Drive SEE on Right: Lot 2

SUBDIVISION Hawkes Bay BLOCK / SECTION — LOT 11 & 11A LOT AREA 3+ 355ft 2500 ft SITE CLASS IV DESIGN FLOW 430 gpd L.T.A.R. 3rd SEE Rpt Ltr

Septic Tank: 4,000 Gallons. STB 312 Date 4-3-99
Pump Tank: 4,000 Gallons. PT — Date 5-13-02
Pump Make: Zoeller Model 16 Serial No —
Nitrification Field: No Fields 1 Square Feet 1080ft Linear Feet 360ft
No Lines 4@ 90ft Trench Width 36" Max Trench Bottom Depth 36" Gravel Depth NA

X New System ☐ Repair System Type I II (III) IV V VI
System Description: pm - Innoflow 25% Reduction
Repair System Description: Similar type on IIA
Maintenance Agreement Required: ☐ Yes X No

X House/Mod Home No. Bedrooms 4
☐ Mobile Home No. Bathrooms 4
☐ Business No. Employees —
☐ Other —


☐ Slab X Crawl Space ☐ Basement w/plumbing ☐ Basement wo/plumbing

Water Supply: X Individual ☐ Public ☐ Community


Comments./Conditions: ① Keep well 100 Ft From ST+PT ② Install lines on contour ③ one inspection port per Material

Comments./Conditions: OKay to move tanks - E 2/4x Installed 360 Ft.

INITIAL SITE SKETCH

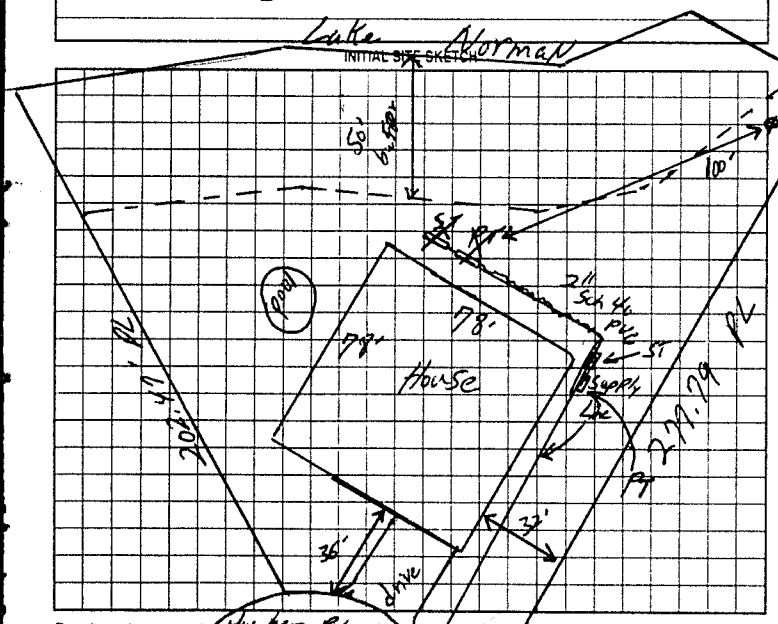

AS BUILT SKETCH

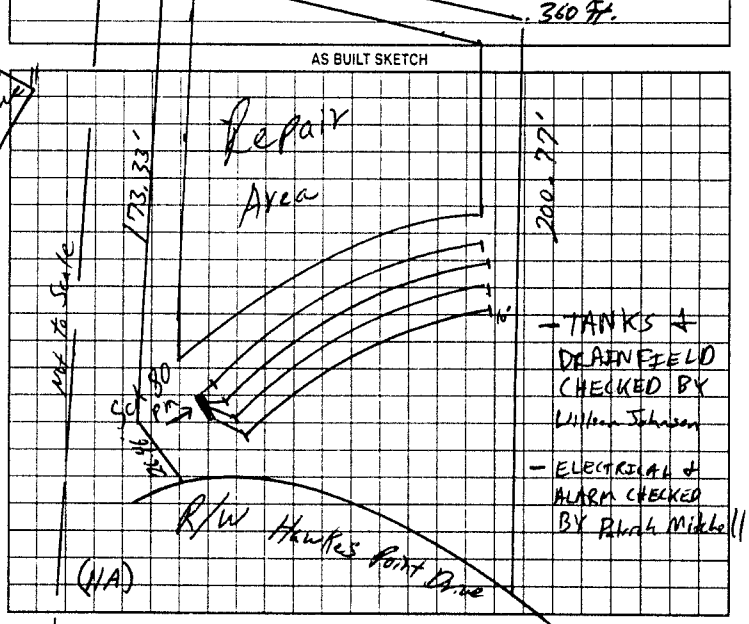

Permit can be suspended or revoked if any false information is supplied toward securing the permit/any unauthorized changes are made to the site any unauthorized changes are made in the installation of the system. Improvement Permit with plat valid without expiration. Improvement Permit with site plan valid for sixty months. Authorization to Construct is valid for a period equal to that of Improvement Permit – not to exceed sixty months.

Signed: — date —

Improvement Permit by: William O. Johnson date 3/15/02

Authorization to Construct by: William E. Johnson date 3/14/02

Installed by: Russell Wolf + Pierce

Operation Permit by: Patrick Mitchell date 08/15/02

Existing System Inspection by: — date —

HEALTH DEPT. COPY WHITE OWNER COPY (FINAL) YELLOW OWNER COPY (INITIAL) PINK