IREDELL COUNTY HEALTH DEPARTMENT

STATESVILLE 704-878-5305 CE MOORESVILLE 704-664-5281

IMPROVEMENT PERMIT / AUTHORIZATION TO CONSTRUCT / OPERATION PERMIT / EXISTING SYSTEM INSPECTION

PERMIT# 0499557 PIN# 4629641777 4629-54-8832 DATE 9-7-04

OWNER OR CONTRACTOR PROVIDENT DEVLPT GROUP PHONE: Business 704 663-6905 Home 704-201-5522

ADDRESS 6207 LAKEVIEW DR SUITE B CHARLOTTE, NC MIKE PEREZ

LOCATION STATE PARK RD (L) MORRISON FARM (R) SUNSET BAY AT END

SUBDIVISION SUNSET BAY BLOCK / SECTION ____ LOT 13 LOT AREA 1.046AC SITE CLASS. PS DESIGN FLOW 480 L.T.A.R. 13

Septic Tank: 1000 Gallons; STB 312 Date 7-18-05

Pump Tank: 1000 Gallons; PT 27 Date 7-29-05

Pump Make: MYERS Model ME-50 Serial No. ME505-21

Nitrification Field: No Fields 1 Square Feet EDZ 1600' Linear Feet 270'

No Lines 4 Trench Width 24" Max Trench Bottom Depth 36" Gravel Depth N/A

(X) New System ☐ Repair System Type: I, II, III, (IV), V, VI

System Description: LP 50% REDUCT

Repair System Description: LP 50% REDUCT

Maintenance Agreement Required: (X) Yes ☐ No

(X) House/Mod. Home No. Bedrooms 4

☐ Mobile Home No. Bathrooms 3½

☐ Business No. Employees ____

☐ Other ____

☐ Slab (X) Crawl Space ☐ Basement w/plumbing ☐ Basement wo/plumbing


Water Supply: ☐ Individual ☐ Public (X) Community

Comments/Conditions: (1) OWNER SAID RETAINING WALLS AT BACK OF HOME WILL NOT BE THERE (2) MAINTAIN SETBACKS & INSTALL LINES ON CONTOURS (3) THIS HOUSE IS A CRAWLSPACE BUT IT WILL ALSO HAVE FOUNDATION DRAINS. KEEP THEM AWAY FROM SYSTEM AREA & MAINTAIN SETBACKS (4) KEEP


Comments/Conditions: STUBOUT HIGH ENOUGH SEPTIC TANKS WILL NOT BE TOO DEEP. (5) HOUSE, DRIVEWAY, SIDEWALKS, PORCHES, 50' SETBACK FROM LAKE & P/L ALL ARE MARKED; ENTIRE SYSTEM WAS FLAGGED AS DRAWN BELOW.

1"=50'

INITIAL SITE SKETCH

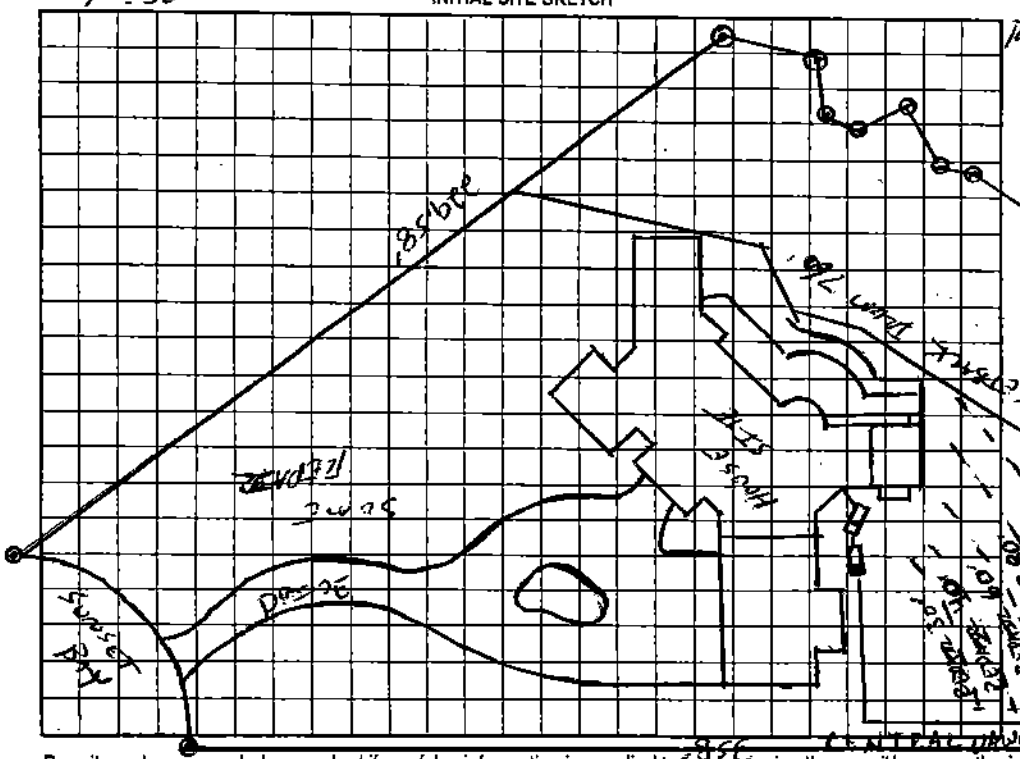

AS BUILT SKETCH

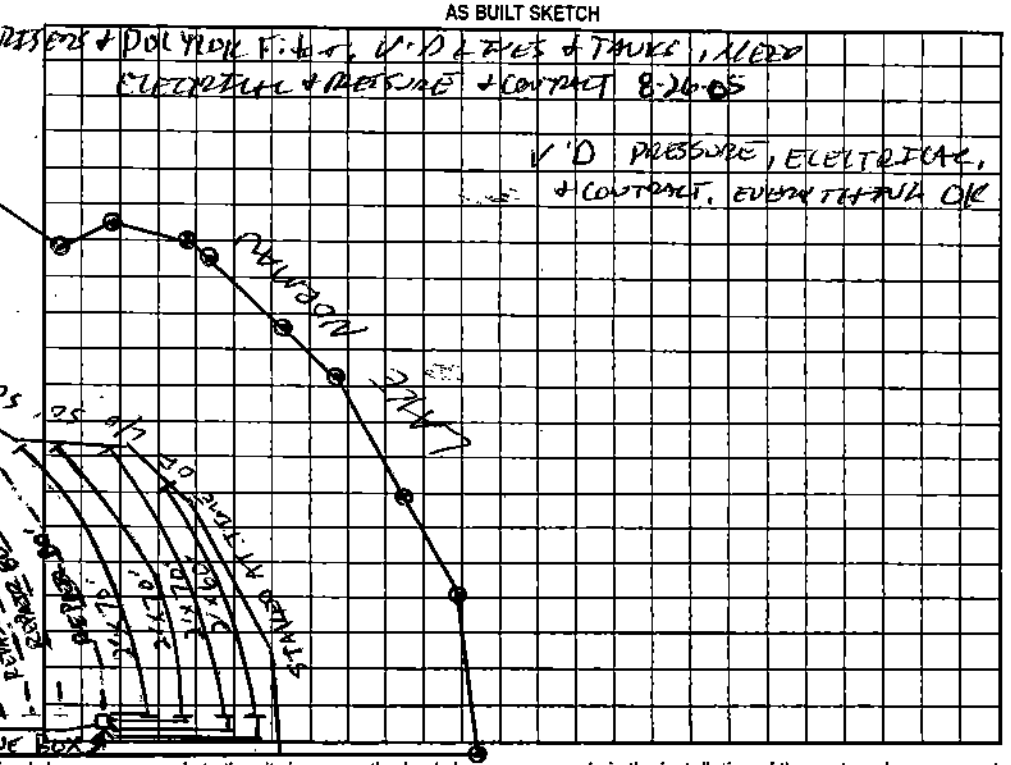

Permit can be suspended or revoked if any false information is supplied toward securing the permit/any unauthorized changes are made to the site/any unauthorized changes are made in the installation of the system. Improvement Permit with plat valid without expiration. Improvement Permit with site plan valid for sixty months. Authorization to Construct is valid for a period equal to that of Improvement Permit – not to exceed sixty months.

Signed: ____ - PROVIDENT HOMES date 9-14-04 Installed by: RJH INC CORPORATED

Improvement Permit by: ____ date 9-7-04 Operation Permit by: ____ date 11-3-05

Authorization to Construct by: ____ date 9-7-04 Existing System Inspection by: ____ date ____

HEALTH DEPT. COPY: WHITE OWNER COPY (FINAL): YELLOW OWNER COPY (INITIAL): PINK