THIS PERMIT REPLACES PREVIOUS ISSUED 5-26-04

DELL COUNTY HEALTH DEPARTMENT

STATESVILLE 704-878-5305 (1) MOORESVILLE 704-664-5281

IMPROVEMENT PERMIT / AUTHORIZATION TO CONSTRUCT / OPERATION PERMIT / EXISTING SYSTEM INSPECTION

PERMIT# 120742 PIN# 4629-55-9610 DATE 6-29-05

OWNER OR CONTRACTOR GEORGE M. FAYI PHONE: Business % 704-799-2696 Home 401-965-0955

ADDRESS 1 HOLLY LANE, BARRINGTON RI 02806

LOCATION STATE PARK RD TO MORRISON FARM RD, TR ROUNDSTONE RD, TR FARLEY LANE LOT AT END ON LEFT

SUBDIVISION DUKE POWER BLOCK / SECTION 17 LOT 189 LOT AREA 0.68 ACRE SITE CLASS PS DESIGN FLOW 480 L.T.A.R. 0.60 GPD/FT2

Septic Tank: 1000 Gallons; STB 760 Date 3-7-05
Pump Tank: 1000 Gallons; PT 363 Date 3-7-05
Pump Make: ZOELLAR Model EBN 151-A Serial No.
Nitrification Field: No Fields 1 Square Feet 800 Linear Feet 135'
No Lines FOUR Trench Width 36" Max Trench Bottom Depth 24" Gravel Depth

☑ New System ☐ Repair System Type: I, II, III, IV, V, VI
System Description: 50% REDUCTION, PUMP
Repair System Description 50% REDUCTION, PUMP
Maintenance Agreement Required: ☐ Yes ☑ No


☑ House/Mod. Home No. Bedrooms 4
☐ Mobile Home No. Bathrooms 3½
☐ Business No. Employees
☐ Other
☐ Slab ☑ Crawl Space ☑ Basement w/plumbing ☐ Basement wo/plumbing

Water Supply: ☑ Individual ☐ Public ☐ Community WELL

Comments/Conditions: (1) KEEP SYSTEM MINIMUM 5' FROM PROPERTY LINE, 50' FROM HIGH WATER LINE (760' ELEVATION) (2) INSTALL 50% REDUCTION SYSTEM ON CONTOUR USING 32 PPBPS PANELS

Comments:/Conditions: SEPTIC TANK WITH MARKER INSTALLED USING RED "POLYLOK" FILTER

INITIAL SITE SKETCH

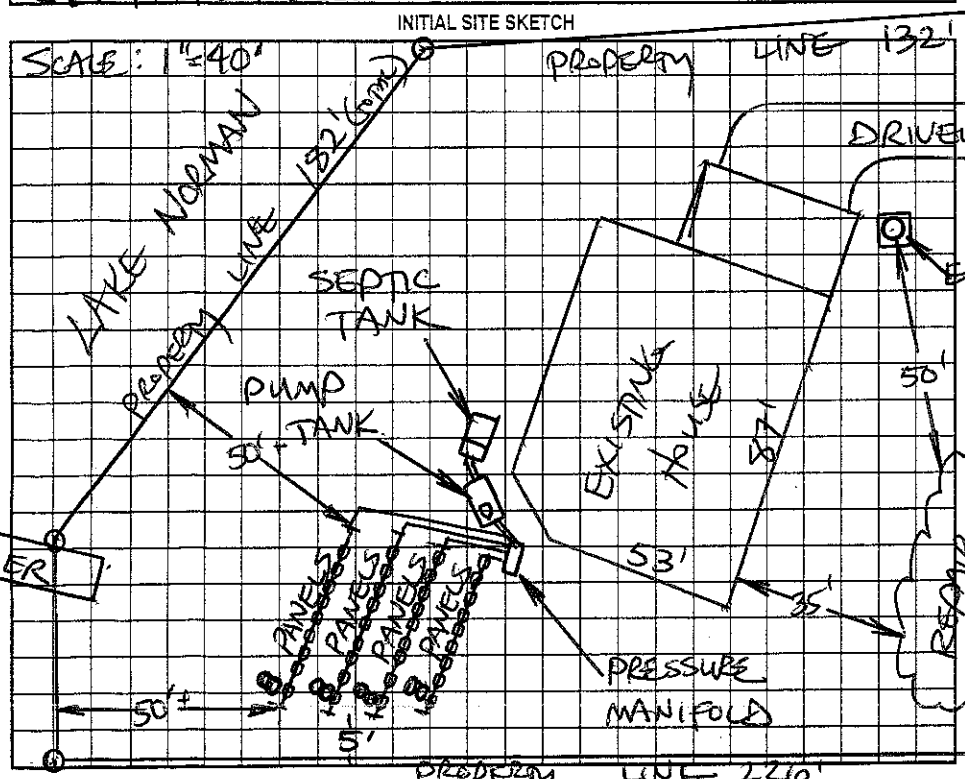

AS BUILT SKETCH

SYSTEM INSTALLED DURING PERIOD OF VERY WET SOIL CONDITIONS — AS SHOWN ON INITIAL SITE SKETCH

Permit can be suspended or revoked if any false information is supplied toward securing the permit/any unauthorized changes are made to the site/any unauthorized changes are made in the installation of the system. Improvement Permit with plat valid without expiration. Improvement Permit with site plan valid for sixty months. Authorization to Construct is valid for a period equal to that of Improvement Permit – not to exceed sixty months.

Signed: Sammy Reavis date 7-1-05 Installed by: SAMMY REAVIS

Improvement Permit by: STEVE HEDRICK date 6-29-05 Operation Permit by: STEVE HEDRICK date 9-7-05

Authorization to Construct by: STEVE HEDRICK date 6-29-05 Existing System Inspection by: date

HEALTH DEPT. COPY: WHITE OWNER COPY (FINAL): YELLOW OWNER COPY (INITIAL): PINK