CRAIG CARTER

IREDELL COUNTY HEALTH DEPARTMENT

STATESVILLE 704-878-5305 MOORESVILLE 704-664-5281

IMPROVEMENT PERMIT / AUTHORIZATION TO CONSTRUCT / OPERATION PERMIT / EXISTING SYSTEM INSPECTION

PERMIT# 074900 PIN# 4639734550 PT DATE 11/6/98

OWNER OR CONTRACTOR Crescent Resources PHONE: Business 663-6905 Home

ADDRESS P.O. Box 1003 Charlotte, NC 28201

LOCATION State Pk Rd TL Wildlife Bay TR SIERRA Woods TL Deer Run at End.

SUBDIVISION Wildlife Bay BLOCK / SECTION I LOT 25/25A LOT AREA 42,368 SITE CLASS. PS DESIGN FLOW 480gpd L.T.A.R. .3

Septic Tank: 1000 Gallons; STB 794 Date 9-22-01
Pump Tank: 1000 Gallons; PT 27 Date 9-19-01
Pump Make: ZOELLER Model E191-A Serial No. PN191 0004
Nitrification Field: No Fields 1 Square Feet 1200' Linear Feet 400'
No Lines 5 at 80' Trench Width 36" Max Trench Bottom Depth 36" Gravel Depth N/A

[X] New System [ ] Repair System Type: I, II, III, IV, V, VI
System Description: Pump-(Pm) 25% Reduction
Repair System Description: Same
Maintenance Agreement Required: [ ] Yes [X] No
[ ] Slab [ ] Crawl Space [X] Basement w/plumbing [ ] Basement wo/plumbing


[X] House/Mod. Home No. Bedrooms 4
[ ] Mobile Home No. Bathrooms 4
[ ] Business No. Employees
[ ] Other

Water Supply: [ ] Individual [ ] Public [X] Community


Comments:/Conditions: Keep Septic System 50' From Lake & 10' from PL

Comments:/Conditions: LARRY BEAM CALLED ON 10-30-01; CHANGED TANK LOCATION TO 306.51 SIDE OF HOUSE BECAUSE HOUSE DOES NOT HAVE BASEMENT. (LC)

INITIAL SITE SKETCH Scale 1:100

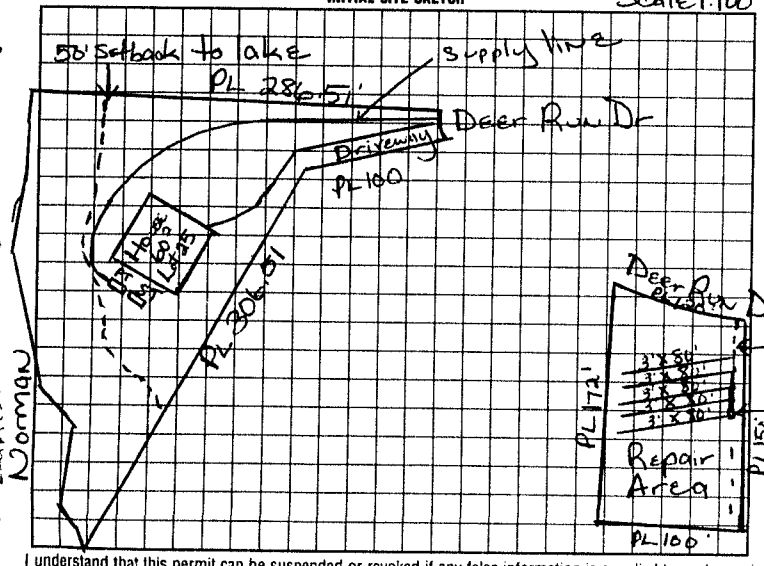

AS BUILT SKETCH

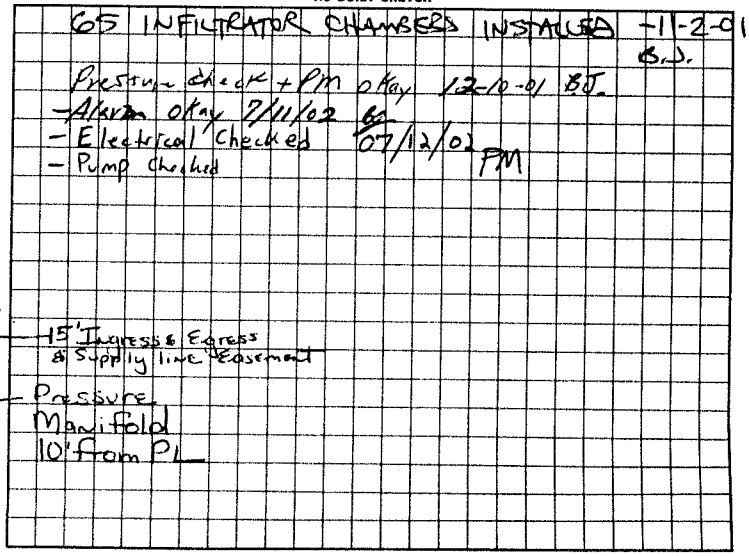

I understand that this permit can be suspended or revoked if any false information is supplied toward securing the permit/any unauthorized changes are made to the site/any unauthorized changes are made in the installation of the system. Improvement Permit with plat valid without expiration. Improvement Permit with site plan valid for sixty months. Authorization to Construct is valid for a period equal to that of Improvement Permit – not to exceed sixty months.

Signed: Paul C. Penny date 11-8-98
Improvement Permit by: Maria H. Dotson R.S. date 11/6/98
Authorization to Construct by: STEVE HENDRICK date 6-26-01

Installed by: LARRY BEAM
Operation Permit by: Patrick Mitchell date 07/12/02
Existing System Inspection by: date

HEALTH DEPT. COPY: WHITE INSPECTION COPY (FINAL). GREEN OWNER COPY (FINAL). YELLOW INSPECTION COPY (INITIAL): PINK OWNER COPY (INITIAL): GOLD