PAUL HOWARD 704-746-7244 732616/1952 CI

IREDELL COUNTY HEALTH DEPARTMENT

THIS PERMIT REPLACES EXPIRED PERMIT # 074901

STATESVILLE 704-878-5305 MOORESVILLE 704-664-5281

IMPROVEMENT PERMIT / AUTHORIZATION TO CONSTRUCT / OPERATION PERMIT / EXISTING SYSTEM INSPECTION

PERMIT# 146221 PIN# 4629-58-5733 DATE 11-7-07

OWNER OR APPLICANT MKM BUILDERS LLC PHONE: Business 980-722-3343 Home 704-895-6081

ADDRESS 17014 WINGED THISTLE COURT DAVIDSON NC 28036

LOCATION STATE PARK ROAD TO WILDLIFE ROAD R TR WILDLIFE BAY TL DEER RUN AT END ON RIGHT

SUBDIVISION WILDLIFE BAY BLOCK / SECTION 1 LOT 26 LOT AREA 30,442 SF SITE CLASS PS DESIGN FLOW 480 L.T.A.R. 0.30 GPD/FT

Septic Tank: 1000 Gallons: STB 794 Date 10-5-07

Pump Tank: 1000 Gallons: PT 27 Date 10-7-07

Pump Make: Liberty Model [illegible] Serial No [illegible]

Nitrification Field: No Fields 1 Square Feet 1600 Linear Feet 270

No Lines SIX Trench Width 24" Max Trench Bottom Depth 30" Min Trench Depth 24"

☑ New System ☐ Repair ☐ Expansion System Type: I II III IV V VI

System Description: 50% REDUCTION PRES. MANIFOLD

Repair System Description: OFF SITE LOT 26A, 50%

Maintenance Agreement Required: ☐ Yes ☑ No REDUCTION

☑ House/Mod. Home ☐ Mobile Home ☐ Business ☐ Other

No. Bedrooms 4 No. Persons ___ No. Employees ___


Water Supply: ☐ Individual ☐ Public ☐ Community

☐ Gravity ☑ Pressure ☐ Slab ☑ Crawl Space ☐ Basement w/plumbing ☐ Basement wo/plumbing


Comments/Conditions: ① INSTALL 50% REDUCTION SYSTEM ON CONTOUR AS SHOWN USING 60 PPBPS PANELS NO DEEPER THAN 30 INCHES ② SEE ATTACHED SHEETS FOR PUMP AND PRESSURE MANIFOLD REQUIREMENTS.

Comments/Conditions: Filter installed.

INITIAL SITE SKETCH

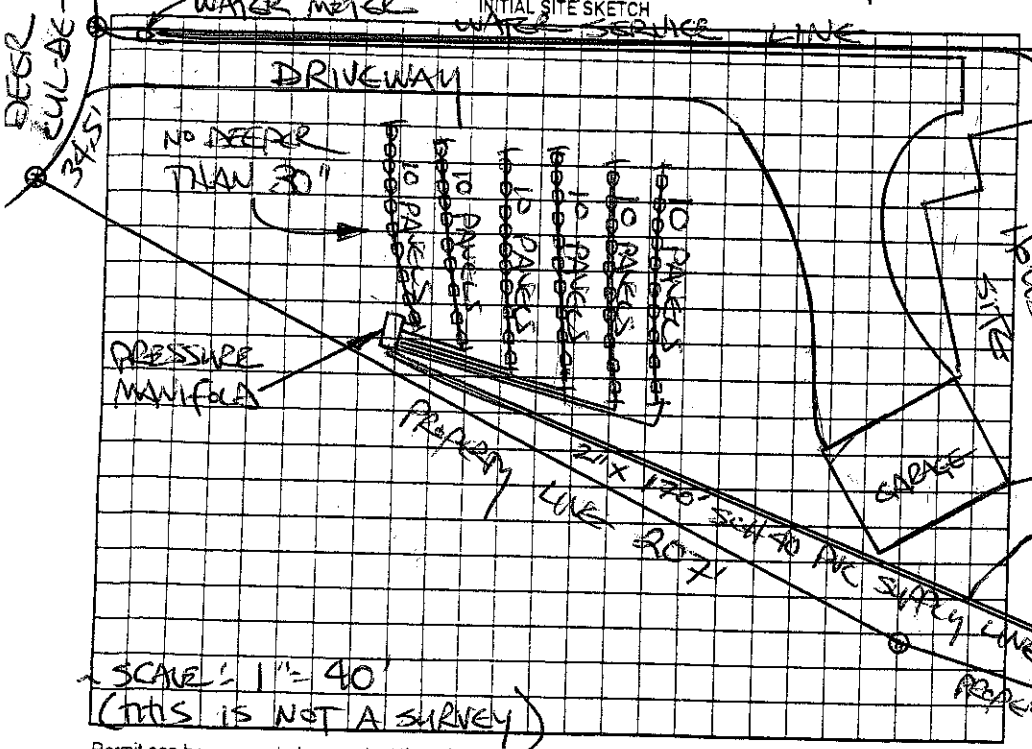

AS BUILT SKETCH

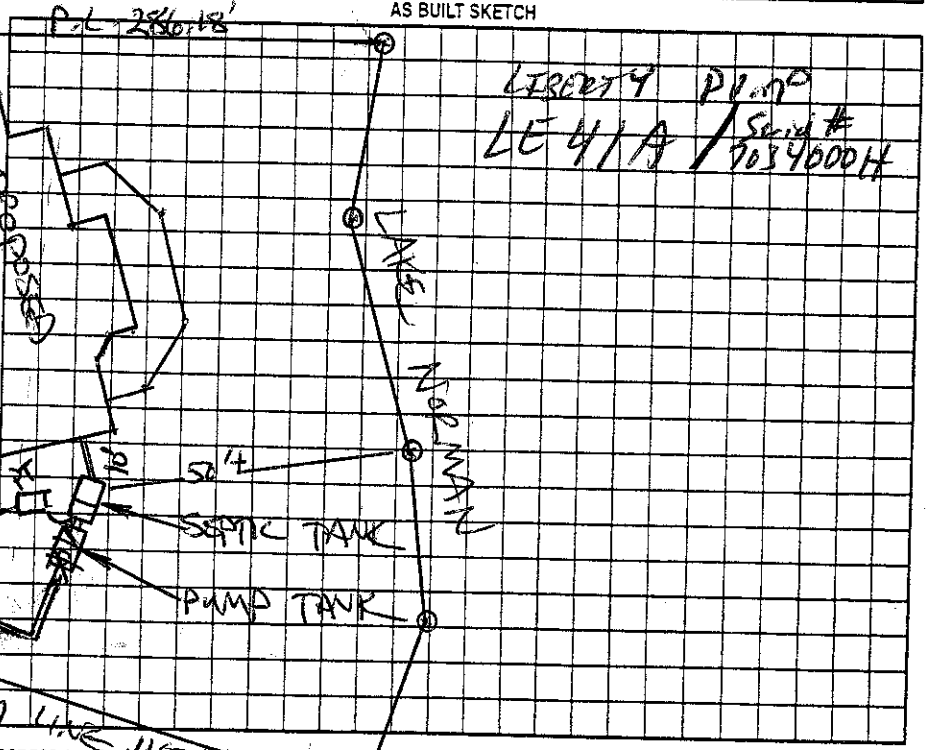

Permit can be suspended or revoked if any false information is supplied toward securing the permit/any unauthorized changes are made to the site/any unauthorized changes are made in the installation of the system. Improvement Permit with plat/valid without expiration ☐ Improvement Permit with site plan valid for sixty months ☑ Authorization to Construct is valid for a period equal to that of Improvement Permit – not to exceed sixty months.

Signed: [signature] date 11-7-07

Improvement Permit by: STEVE HENDRICK date 11-7-07

Authorization to Construct by: STEVE HENDRICK date 11-7-07

Installed by: Corinthian Building LTD

Operation Permit by: [signature] date 7-16-08

Existing System Inspection by: ___ date ___

HEALTH DEPT. COPY: WHITE OWNER COPY (FINAL): YELLOW OWNER COPY (INITIAL): PINK