IREDELL COUNTY HEALTH DEPARTMENT

THIS PERMIT REPLACES PREVIOUS ISSUED 10/27/98

STATESVILLE 704-878-5305 (P) MOORESVILLE 704-664-5281

IMPROVEMENT PERMIT / AUTHORIZATION TO CONSTRUCT / OPERATION PERMIT / EXISTING SYSTEM INSPECTION

PERMIT# 074882 PIN# 4629-58-7173 DATE 11-1-03

OWNER OR CONTRACTOR WILLIAM J. MARK PHONE: Business 704-534-1499 Home 704-896-0773

ADDRESS 114 PARK VIEW LANE TROUTMAN NC 28166

LOCATION STATE PARK ROAD TO WILDLIFE ROAD, TR SIERRA WOODS DR, TL DEER RUN, TL PARK VIEW, LOT ON (R)

SUBDIVISION WILDLIFE BAY BLOCK / SECTION I LOT 20 LOT AREA 1.18 ACRES SITE CLASS. PS DESIGN FLOW 480 L.T.A.R. 0.30 GPD/FT²

Septic Tank: 1000 Gallons STB ~~3184~~ Date 2-12-03

Pump Tank: 1000 Gallons; PT Date 1-14-03

Pump Make: ZOELLER Model E165-C Serial No.

Nitrification Field: No Fields 1 Square Feet/Trench 1600 Linear Feet 400

No Lines FOUR Trench Width 36" Max Trench Bottom Depth 36" Gravel Depth N/A

☑ New System ☐ Repair System Type: I, II, (III), IV, V, VI

System Description: 25% REDUCTION, PUMP

Repair System Description: SD 2 REDUCTION, LOW PRESSURE

Maintenance Agreement Required: ☐ Yes ☑ No

☑ House/Mod. Home ☐ Mobile Home ☐ Business ☐ Other

No. Bedrooms 4 No. Bathrooms 4 1/2 No. Employees


Water Supply: ☐ Individual ☑ Public ☐ Community

☐ Slab ☑ Crawl Space ☐ Basement w/plumbing ☐ Basement wo/plumbing


Comments:/Conditions: ① INSTALL 25% REDUCTION SYSTEM ~~FOR~~ AS SHOWN IN FOUR (4) EQUAL LENGTH LINES ON CONTOUR ② SEE ATTACHED SHEETS FOR PUMP & PRESSURE MANIFOLD REQUIREMENTS

Comments:/Conditions: DRAINLINES INSPECTED 11-4-03, OK

INITIAL SITE SKETCH

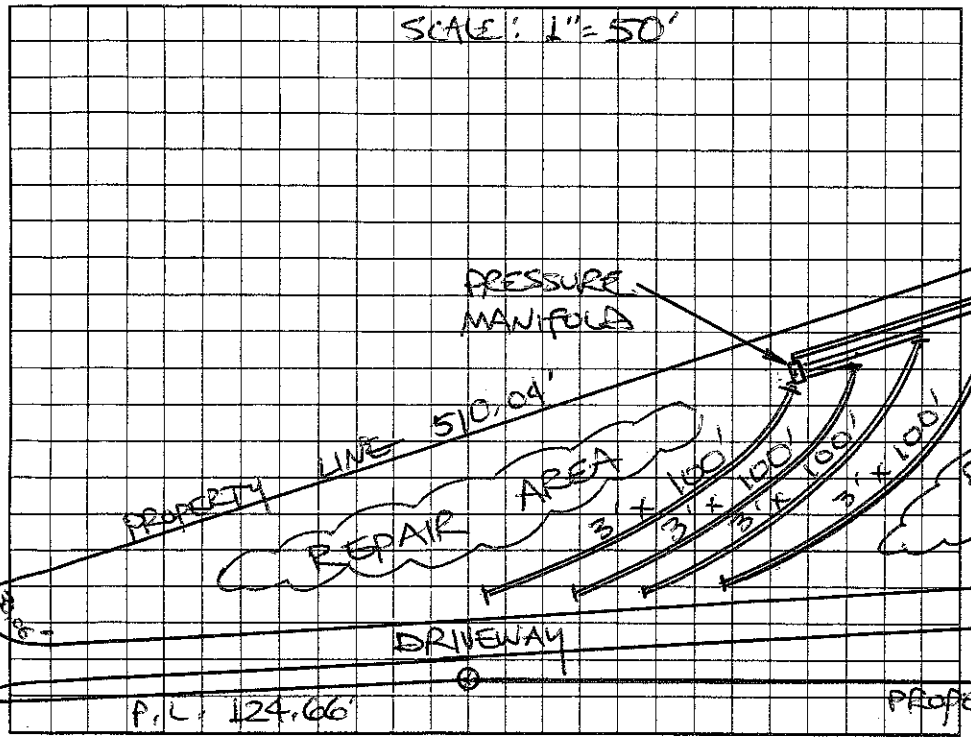

AS BUILT SKETCH

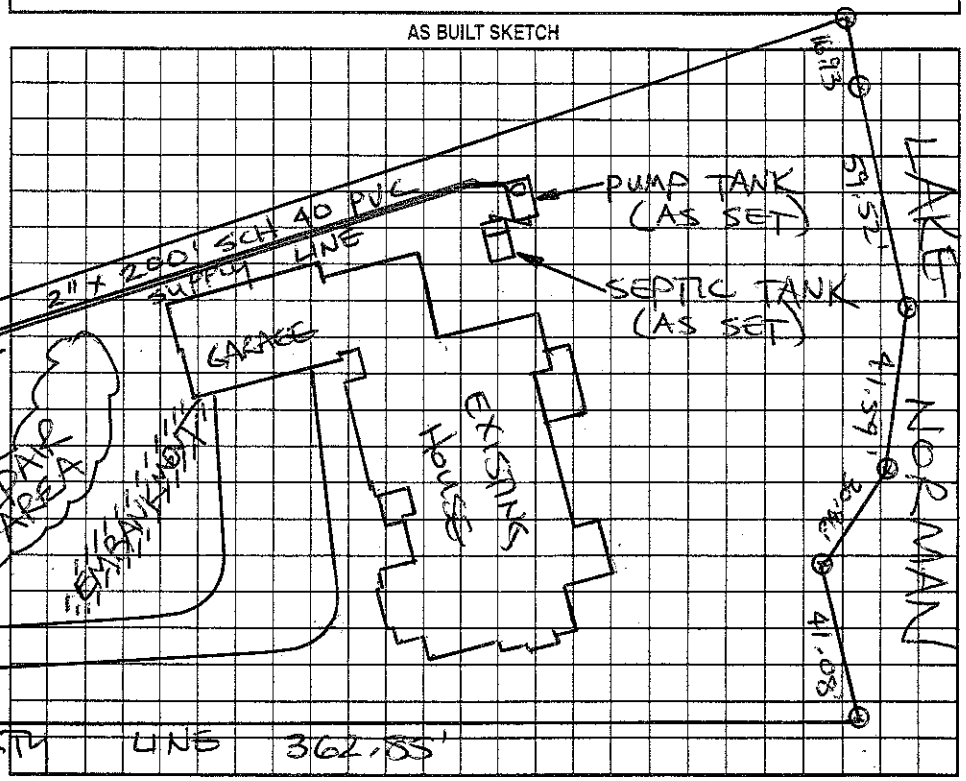

Permit can be suspended or revoked if any false information is supplied toward securing the permit/any unauthorized changes are made to the site/any unauthorized changes are made in the installation of the system. Improvement Permit with plat valid without expiration. Improvement Permit with site plan valid for sixty months. Authorization to Construct is valid for a period equal to that of Improvement Permit – not to exceed sixty months.

Signed: Craig Mark Roseman date 11-4-03 Installed by: LITTLE HAWKINS

Improvement Permit by: STEVE HEDRICK date 11-1-03 Operation Permit by: STEVE HEDRICK date 11-14-03

Authorization to Construct by: STEVE HEDRICK date 11-1-03 Existing System Inspection by: date

HEALTH DEPT. COPY: WHITE OWNER COPY (FINAL): YELLOW OWNER COPY (INITIAL): PINK