IREDELL COUNTY HEALTH DEPARTMENT

STATESVILLE 704-878-5305 (I) MOORESVILLE 704-664-5281

IMPROVEMENT PERMIT / AUTHORIZATION TO CONSTRUCT / OPERATION PERMIT / EXISTING SYSTEM INSPECTION

PERMIT# 123047 PIN# 4629-58-9769 DATE 8-13-04

OWNER OR CONTRACTOR LEONARD WILSON PHONE: Business 704-622-2323 Home 704-542-5412

ADDRESS PO BOX 85 DAVIDSON, NC 28036

LOCATION STATE RD (S) WILDLIFE (R) SIERRA WOOD (L) DEER RUN LOT 24 ON LEFT

SUBDIVISION Wildlife Bay BLOCK / SECTION I LOT 24/24A LOT AREA 14238 sq ft +.57AC SITE CLASS. PS DESIGN FLOW 360 L.T.A.R. .3

Septic Tank: 1000 Gallons; STB 1012 Date 7-6-04
Pump Tank: 1000 Gallons; PT 17 Date 8-12-04
Pump Make: GOULDS Model WE012HO Serial No. L0480507
Nitrification Field: No Fields 1 Square Feet EU=1200' Linear Feet 300'
No Lines 3x100' Trench Width 36" Max Trench Bottom Depth 36" Gravel Depth N/A

☒ New System ☐ Repair System Type: I, II, ☒ III, IV, V, VI
System Description: PUMP OFFSITE 35% RED
Repair System Description: LP 50% REDUCT OFFSITE & OUTSITE
Maintenance Agreement Required: ☐ Yes ☒ No

☒ House/Mod. Home No. Bedrooms 3
☐ Mobile Home No. Bathrooms 3 1/2
☐ Business No. Employees
☐ Other


☐ Slab ☐ Crawl Space ☒ Basement w/plumbing ☐ Basement wo/plumbing

Water Supply: ☐ Individual ☐ Public ☒ Community

Comments:/Conditions: (1) HOUSE SITE & P/L MARKED (2) SUPPLY INSTALLED PRIOR TO ROAD CONSTRUCTION (3) INSTALL LINES ON CONTOURS (4) MAINTAIN SETBACKS (5) MAINTAIN PROPER RULES ADDRESS TO DRIVEWAY CROSSINGS. (6) EVALUATE BASEMENT


Comments:/Conditions: CUT SO TANK LOCATION WILL STILL BE OUT OF THE 50' SETBACK FROM LAKE. (7) CALL PRIOR TO INSTALLATION FOR SYSTEM SPECS & SIZING IF NECESSARY NO PERMISSIVE ELECTRICAL TAPE ON 2-22-05

INITIAL SITE SKETCH

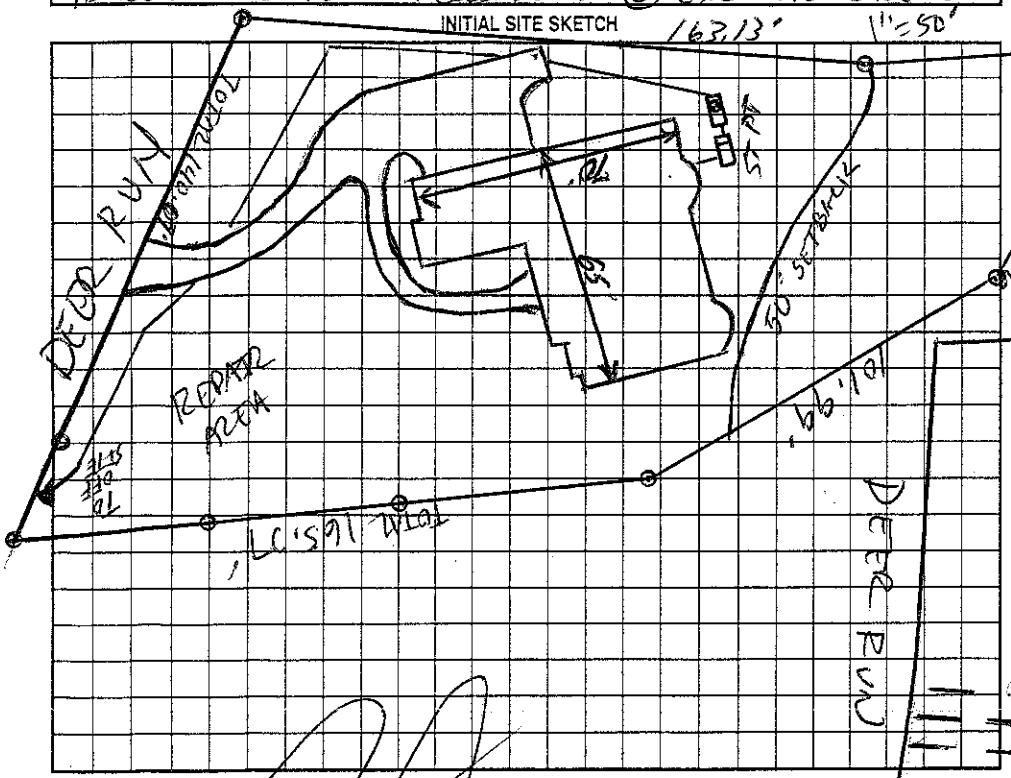

AS BUILT SKETCH

SYSTEM IS 6' OFF MARKED P/L
SUPPLY IS 5' OFF MARKED P/L
TUFF TITE FILTER #MH1167 12-28-04
TANKS 50'+ OFF 760, MARKED BY STAKES

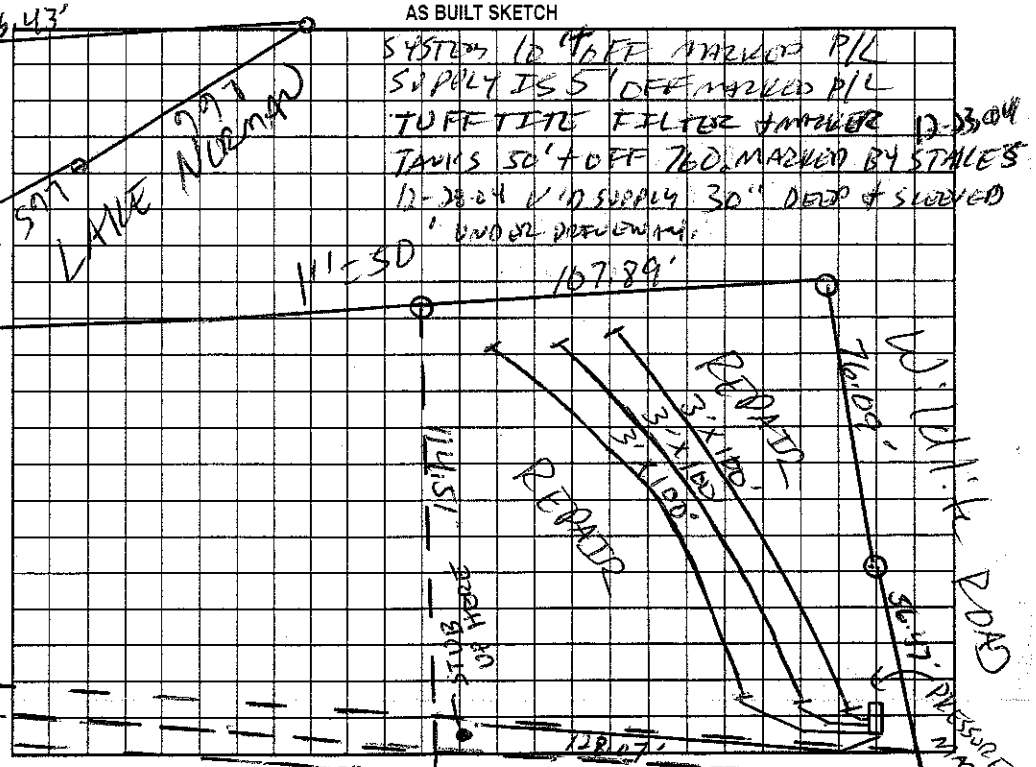

Permit can be suspended or revoked if any false information is supplied toward securing the permit, any unauthorized changes are made to the site/any unauthorized changes are made in the installation of the system. Improvement Permit with plat valid without expiration. Improvement Permit with site plan valid for sixty months. Authorization to Construct is valid for a period equal to that of Improvement Permit – not to exceed sixty months.

Signed: _____ date 8-23-04 Installed by: STEVE JORDAN

Improvement Permit by: _____ date 8-13-04 Operation Permit by: _____ date 2-22-05

Authorization to Construct by: _____ date 8-13-04 Existing System Inspection by: _____ date _____

HEALTH DEPT. COPY: WHITE OWNER COPY (FINAL): YELLOW OWNER COPY (INITIAL): PINK