RANDY MELTON 704-857-6426 CS Called 6-26-07 @ 4:32

IREDELL COUNTY HEALTH DEPARTMENT

STATESVILLE 704-878-5305 MOORESVILLE 704-664-5281

IMPROVEMENT PERMIT / AUTHORIZATION TO CONSTRUCT / OPERATION PERMIT / EXISTING SYSTEM INSPECTION

PERMIT# 117958 PIN# 4629595538 DATE 12/27/06

OWNER OR APPLICANT SPIVEY CONST PHONE: Business 704-663-4189 Home 704-363-0214 Brad Stewart

ADDRESS PO BOX 4268 MOORESVILLE NC 28117

LOCATION State Park Rd (L) Wildlife (R) Silver Lodges (L) Deer Run (R) Eagle Chase 300 on left past Hawks Run

SUBDIVISION Wildlife Bay BLOCK / SECTION 1 LOT 43 LOT AREA 1.09AC SITE CLASS. PS DESIGN FLOW 360 L.T.A.R. .3

Septic Tank: 1000 Gallons; STB 794 Date 1-26-07
Pump Tank: 1000 Gallons; PT 360 Date 11-12-06
Pump Make: _____ Model _____ Serial No. _____
Nitrification Field: No Fields 1 Square Feet ED=1200' Linear Feet 300'
No Lines 4x75' Trench Width 36" Max Trench Bottom Depth 36" Gravel Depth N/A ☐ Gravity ☒ Pressure

☒ New System ☐ Repair ☐ Expansion System Type: I II III IV V VI
System Description: Pump 25% Reduct
Repair System Description: LP 25% Reduct
Maintenance Agreement Required: ☐ Yes ☒ No

☒ House/Mod. Home ☐ Mobile Home ☐ Business ☐ Other
No. Bedrooms 3 No. Persons 6 No. Employees ____

Water Supply: ☐ Individual ☐ Public ☒ Community

☐ Slab ☐ Crawl Space ☒ Basement w/plumbing ☐ Basement wo/plumbing

Comments/Conditions: (1) CALL Prior to installation For Pump Sizing & System Specs if necessary (2) Install Lines on contours & maintain setbacks (3) See Comments on Permit Sketch.

Comments/Conditions: POLYLOK Filter & Marker
Builder OK'd System Changes Dean Hudgins

INITIAL SITE SKETCH

SEE ATTACHED SYSTEM DESIGN BY LORNE COOK, P.S.

AS BUILT SKETCH

Due to Tree Stumps, Roots, & Humps & Rocks, system was installed at 36" Deep to prevent possible bleed out.

Permit can be suspended or revoked if any false information is supplied toward securing the permit/any unauthorized changes are made to the site/any unauthorized changes are made in the installation of the system. Improvement Permit with plat valid without expiration ☐ Improvement Permit with site plan valid for sixty months ☐ Authorization to Construct is valid for a period equal to that of Improvement Permit – not to exceed sixty months.

Signed: [signature] date 6/29/07 Installed by: Piedmont Septic TANK

Improvement Permit by: [signature] date 12/27/06 Operation Permit by: [signature] date 5-18-07

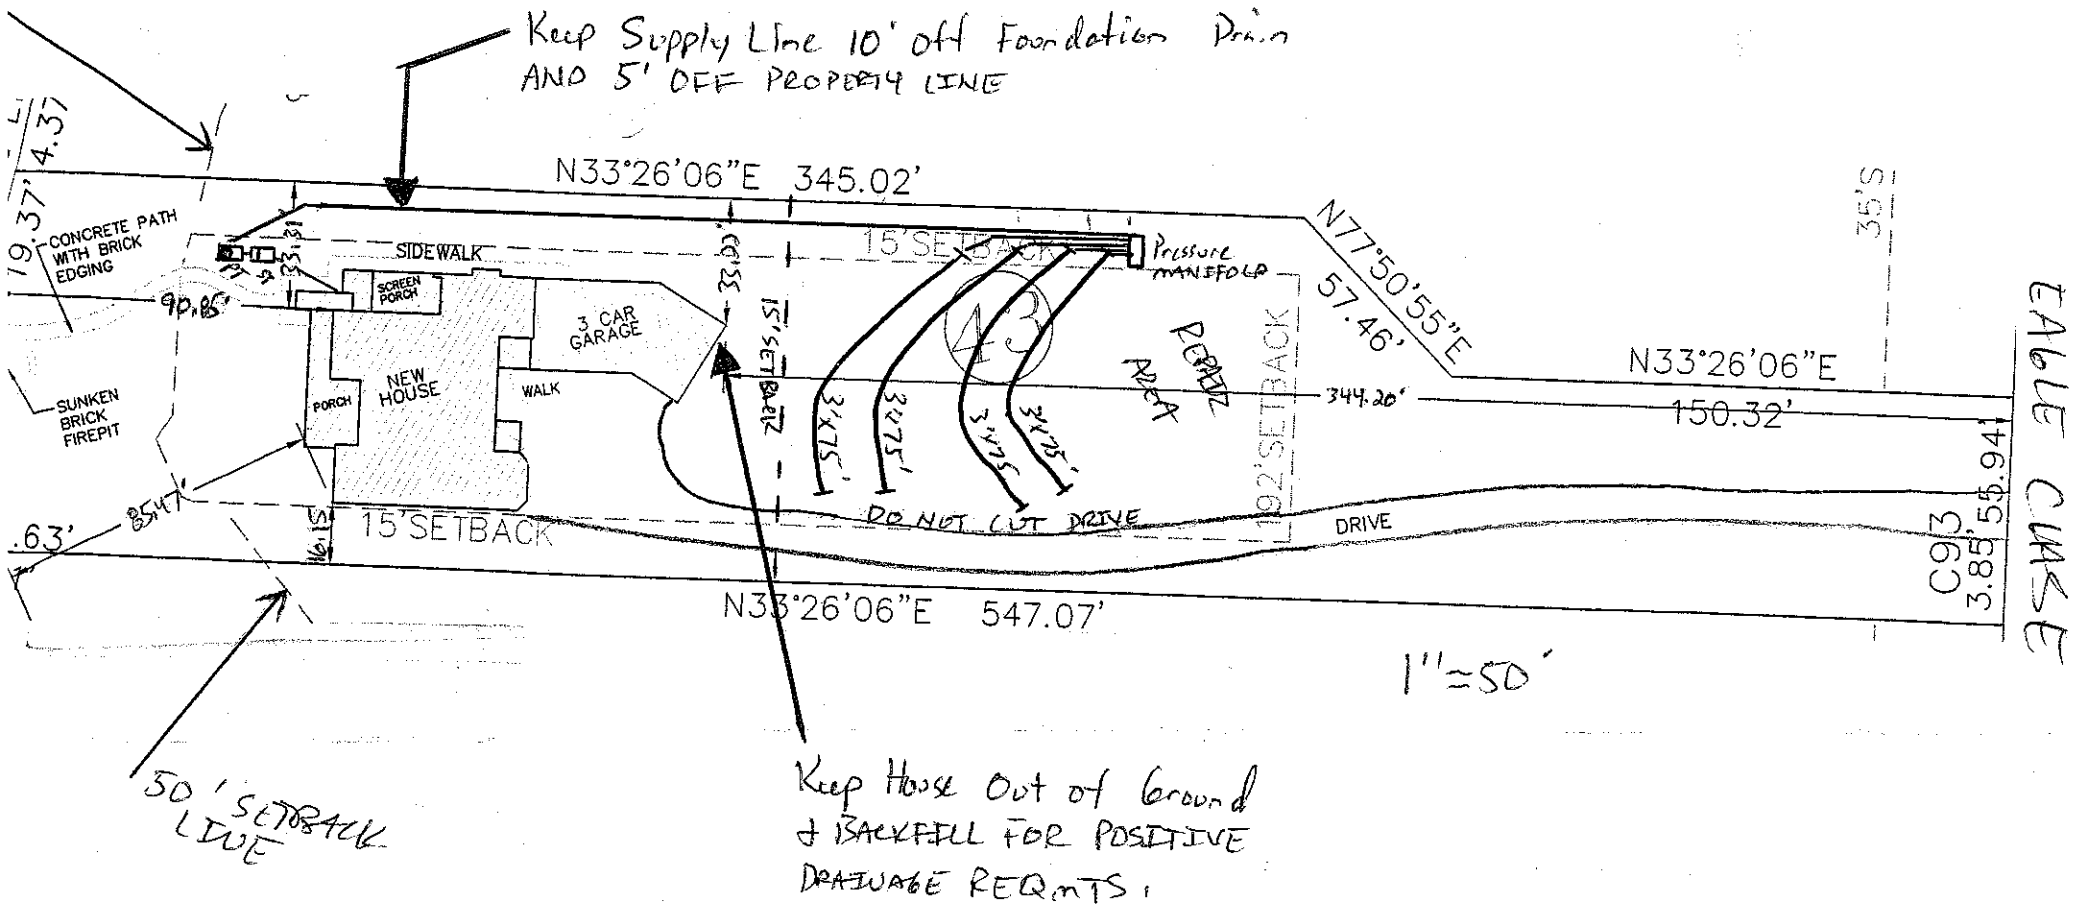
Authorization to Construct by: [signature] date 12/27/06 Existing System Inspection by: _____ date _____

HEALTH DEPT. COPY: WHITE OWNER COPY (FINAL): YELLOW OWNER COPY (INITIAL): PINK

For:

mIT #

PIM #


Keep Supply Line 10' off Foundation Drip
AND 5' OFF PROPERTY LINE
N33°26'06"E 345.02'
CONCRETE PATH WITH BRICK EDGING
SIDEWALK
SCREEN PORCH
3 CAR GARAGE
NEW HOUSE
PORCH
WALK
SUNKEN BRICK FIREPIT
15' SETBACK
Pressure MANIFOLD
N77°50'55"E
57.46'
N33°26'06"E
344.20'
150.32'
192' SETBACK
DO NOT CUT DRIVE
DRIVE
15' SETBACK
N33°26'06"E 547.07'
EAGLE CHASE
C93
3.85'
55.94'
35'S
1"=50'
50' SETBACK LINE
Keep House Out of Ground & BACKFILL FOR POSITIVE DRAINAGE REQmTS.