Note: This Permit voids Previous Issued permit 11-2-98 + Expires 11/2/03.

IREDELL COUNTY HEALTH DEPARTMENT

STATESVILLE 704-878-5305 MOORESVILLE 704-664-5281

IMPROVEMENT PERMIT / AUTHORIZATION TO CONSTRUCT / OPERATION PERMIT / EXISTING SYSTEM INSPECTION

PERMIT# 074915 PIN# ~~4639735550 PF~~ ~~4629 690375~~ 4629-59-6134 DATE 10/23/01

OWNER OR CONTRACTOR Jerry E. Burgdorfer ~~PO Box 1303~~ PHONE: Business (704) 822-0963 Home (704) 873-0320

ADDRESS PO Box 1303 Statesville NC 28687

LOCATION State Park Rd (L) Wildlife (R) Sierra Woods (L) Deer Run (R) Eagle Chase (L) Hawk Run e End

SUBDIVISION Wildlife Bay BLOCK / SECTION I LOT 38/38A LOT AREA 34,898 SITE CLASS. P5 DESIGN FLOW 480 gpd L.T.A.R. .3

Septic Tank: 1,000 Gallons; STB 1012 Date 12-29-01
Pump Tank: 1,000 Gallons; PT 17 Date 1-1-02
Pump Make: Goulds Model WE1512 HH Serial No. G025247I
Nitrification Field: No Fields 1 Square Feet 1600 Eq. to Linear Feet 400'
No Lines 4@100 Trench Width 36" Max Trench Bottom Depth 36" Gravel Depth N/A

☒ New System ☐ Repair System Type: I, II, (III) IV, V, VI
System Description: Pump PM-25% Reduction
Repair System Description: Pump, Panel Block
Maintenance Agreement Required: ☐ Yes ☒ No

☒ House/Mod. Home ☐ Mobile Home ☐ Business ☐ Other
No. Bedrooms 4 No. Bathrooms 4 No. Employees ____


☐ Slab ☐ Crawl Space ☒ Basement w/plumbing ☐ Basement wo/plumbing

Water Supply: ☐ Individual ☐ Public ☒ Community


Comments/Conditions: Keep Septic System at min 10ft from PL + 50 ft From Lake

Comments/Conditions: -PW/ok Filter Installed, Checked Tanks ok 11/9/02 wd
-CHECKED LINES ON 07/15/02 (PM)
INSTALLED AS SHOWN BELOW (LINES)
(5-80' LINES.)

INITIAL SITE SKETCH Scale 1:100

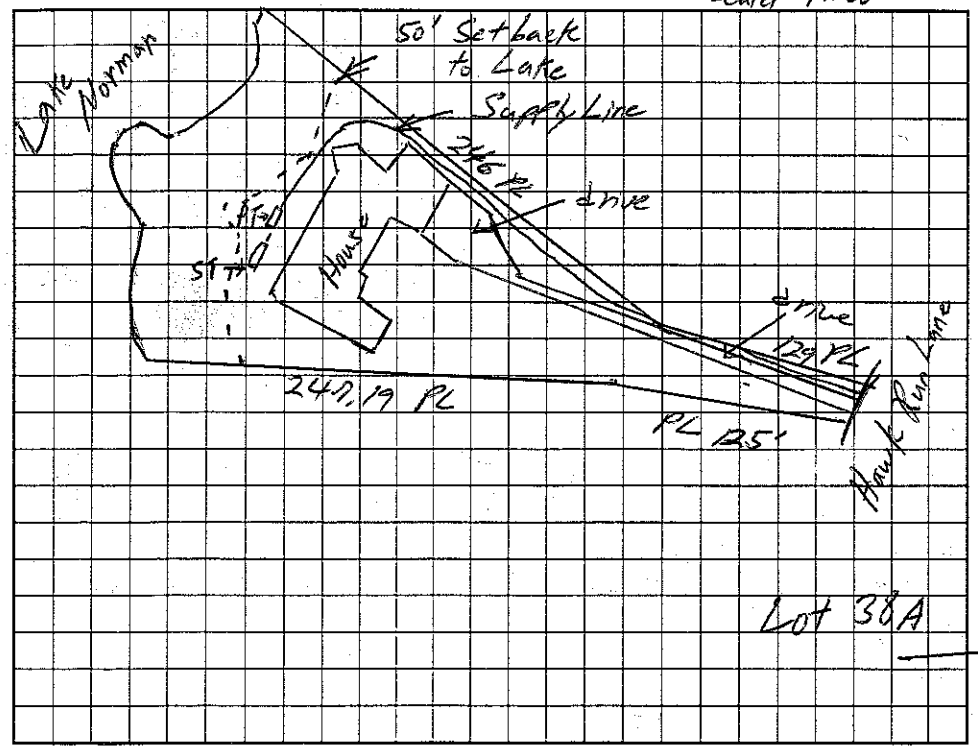

AS BUILT SKETCH

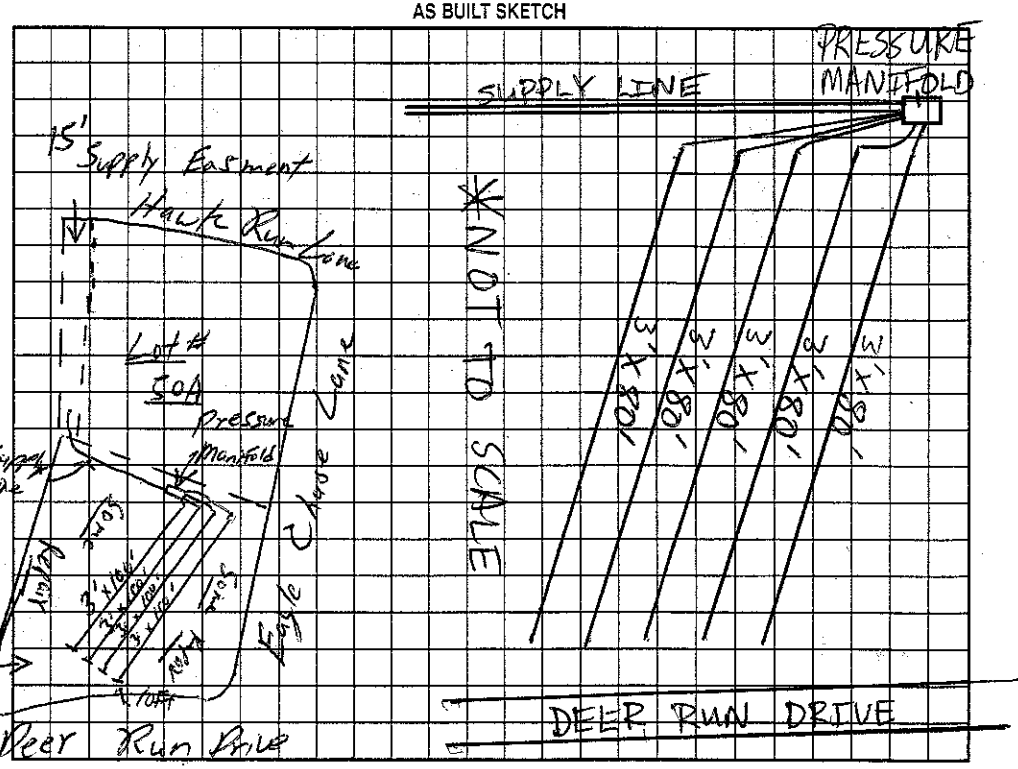

Permit can be suspended or revoked if any false information is supplied toward securing the permit/any unauthorized changes are made to the site/any unauthorized changes are made in the installation of the system. Improvement Permit with plat valid without expiration. Improvement Permit with site plan valid for sixty months. Authorization to Construct is valid for a period equal to that of Improvement Permit – not to exceed sixty months.

Signed: Jerry E. Burgdorfer date 10-25-01
Improvement Permit by: William O. Johnson date 10/23/01
Authorization to Construct by: William O. Johnson date 10/23/01

Installed by: STEVE JORDAN
Operation Permit by: Patrick Mitchell date 01/16/03
Existing System Inspection by: ____ date ____

HEALTH DEPT COPY: WHITE OWNER COPY (FINAL): YELLOW OWNER COPY (INITIAL): PINK