IREDELL COUNTY HEALTH DEPARTMENT

STATESVILLE 704-878-5305 MOORESVILLE 704-664-5281

IMPROVEMENT PERMIT / AUTHORIZATION TO CONSTRUCT / OPERATION PERMIT / EXISTING SYSTEM INSPECTION

PERMIT# 074917 PIN# 4639734550 PT DATE 5/26/2000

OWNER OR CONTRACTOR Crescent Resources/Oscar Koehler PHONE: Business Oscar 309-0227 Home

ADDRESS P.O. Box 1003 Charlotte, NC 28201

LOCATION State Park Rd TL Wildlife, TR Sierra Wood TL Deer Run TR Eagle Chase TL Hawk Run

SUBDIVISION Wildlife Bay BLOCK / SECTION 1 LOT 39 LOT AREA 44,680 sq ft SITE CLASS PS DESIGN FLOW 480 gpd L.T.A.R. .3+ at end

Septic Tank: 1000 Gallons; STB 283 Date 4-23-01

Pump Tank: 1000 Gallons; PT 283 Date 4-23-01

Pump Make Hydromatic Model SHEF50A Serial No 5786-008-7

Nitrification Field: No Fields 1 Square Feet 1200' Linear Feet 400'

No Lines 6 at 67' ea Trench Width 36" Max Trench Bottom Depth 36"

[X] New System [ ] Repair System Type: I, II, III, IV, V, VI

System Description: Pump (pm) - 25% Reduction

Repair System Description Pump - 4PP - Pearl Blk

Maintenance Agreement Required: [ ] Yes [X] No

[X] House/Mod. Home No. Bedrooms 4

[ ] Mobile Home No. Bathrooms 4

[ ] Business No. Employees

[ ] Other


Gravel Depth 10/4 [ ] Slab [ ] Crawl Space [X] Basement w/plumbing [ ] Basement wo/plumbing

Water Supply: [ ] Individual [ ] Public [ ] Community

Comments/Conditions: Keep Septic System 10' From PL & 50' From lake. Keep tanks >15' From Future pool & Gulleys. Tanks Must be at least 5' From house & Drainfield > 25' From basement


INITIAL SITE SKETCH

Scale 1:50

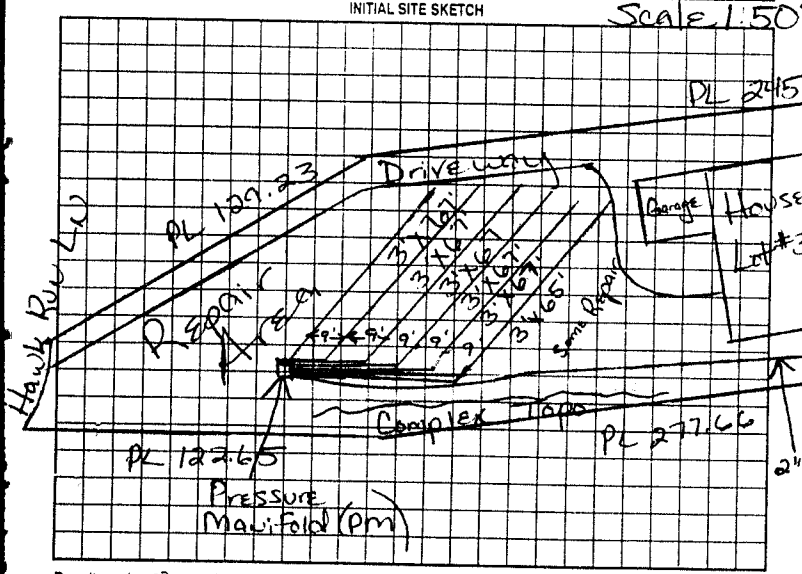

Comments/Conditions: Install lines on contour & stay 15' From Gulley, may install 5 lines at 80' if setbacks can be maintained. (Very tight fit) Replaces permit dated 10/26/98.

AS BUILT SKETCH

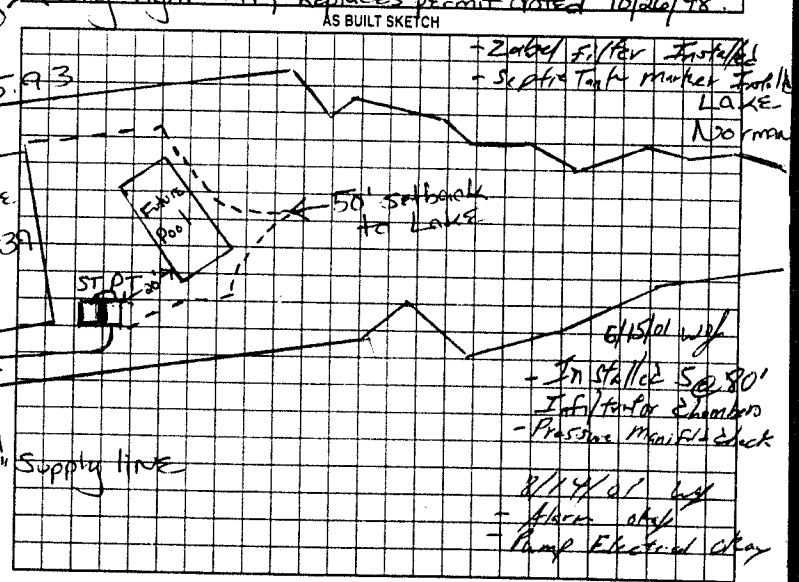

Permit can be suspended or revoked if any false information is supplied toward securing the permit/any unauthorized changes are made to the site/any unauthorized changes are made in the installation of the system. Improvement Permit with plat valid with 5 yr expiration. Improvement Permit with site plan valid for sixty months. Authorization to Construct is valid for a period equal to that of Improvement Permit – not to exceed sixty months.

Signed: _____ date 6/1/00 Installed by: Curt Dunning

Improvement Permit by: Marian H. Dolgos RS date 5/26/2000 Operation Permit by: William C. Johnson date 8/14/01

Authorization to Construct by: Marian H. Dolgos RS date 5/26/2000 Existing System Inspection by: _____ date _____

HEALTH DEPT COPY WHITE OWNER COPY (FINAL) YELLOW OWNER COPY (INITIAL) PINK