IREDELL COUNTY HEALTH DEPARTMENT

STATESVILLE 704-878-5305 MOORESVILLE 704-664-5281

IMPROVEMENT PERMIT / AUTHORIZATION TO CONSTRUCT / OPERATION PERMIT / EXISTING SYSTEM INSPECTION

PERMIT# 074918 PIN# 4639734455 0 PT DATE 11-14-98

OWNER OR CONTRACTOR Crescent Resources PHONE: Business Home

ADDRESS P.O. Box 1003 Charlotte, NC 28201

LOCATION State Park Rd TO Wildlife TR SIERRA Woods TO Deer Run TR Eagle TR Hawk Run 2nd on left

SUBDIVISION Wildlife Bay BLOCK / SECTION I LOT 40/40A LOT AREA 37,890 SITE CLASS PS DESIGN FLOW 480gpd L.T.A.R. .3

Septic Tank: 1000 Gallons; STB 312 Date 6/9/99

Pump Tank: 1000 Gallons; PT 27 Date 8/10/99

Pump Make: Hydromatic Model Shef 50 A11 Serial No. 5186700-7

Nitrification Field: No Fields 1 Square Feet 900' Linear Feet 300'

No Lines 6 at 50' Trench Width 36" Max Trench Bottom Depth 30" Gravel Depth

[X] New System [ ] Repair System Type: I, II, (III), IV, V, VI

System Description: Pump-PM-Panel Blk*

Repair System Description: Same

Maintenance Agreement Required: [ ] Yes [ ] No

[ ] Slab [ ] Crawl Space [X] Basement w/plumbing [ ] Basement wo/plumbing

[X] House/Mod. Home No. Bedrooms 4

[ ] Mobile Home No. Bathrooms 4

[ ] Business No. Employees

[ ] Other


Water Supply: [ ] Individual [ ] Public [X] Community

Comments:/Conditions: Keep Septic System at least 10' From PL & 50' from lake. Septic Drainfield located offsite ON Lot 40A


Comments:/Conditions: * Panel Blk = 50% Reduction in Drain-Field Area.

Line & Pressure Checked 9-14 By MARIA D

INITIAL SITE SKETCH Scale 1:100

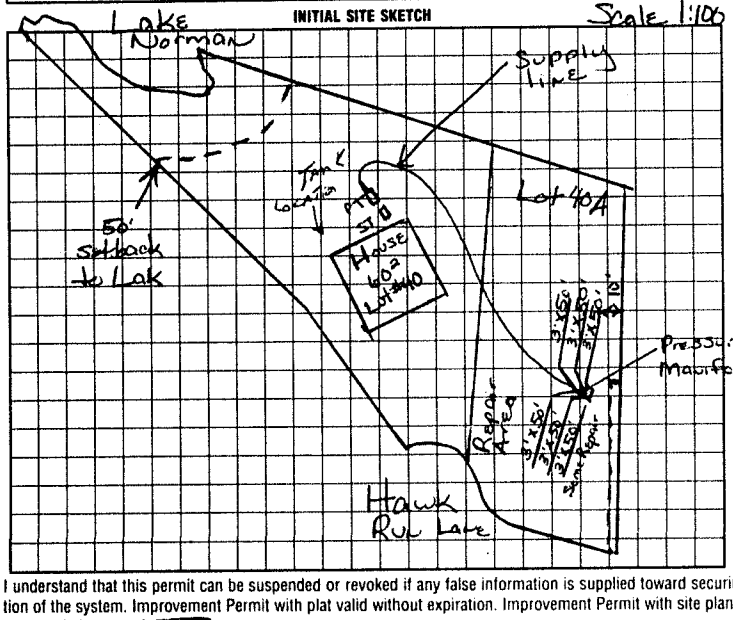

AS BUILT SKETCH

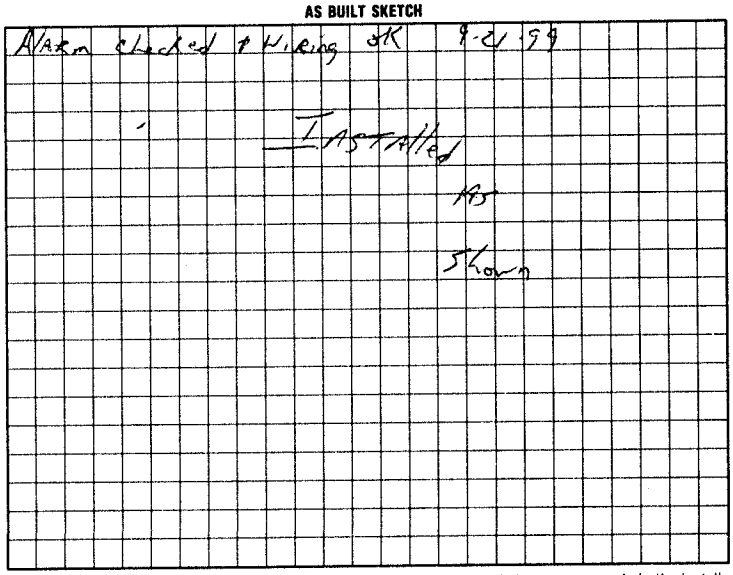

I understand that this permit can be suspended or revoked if any false information is supplied toward securing the permit/any unauthorized changes are made to the site/any unauthorized changes are made in the installation of the system. Improvement Permit with plat valid without expiration. Improvement Permit with site plan valid for sixty months. Authorization to Construct is valid for a period equal to that of Improvement Permit – not to exceed sixty months.

Signed: Paul G. Pugh date 12-4-98

Improvement Permit by: Marion Hall Dotson date 11/14/98

Authorization to Construct by: Joe Potter date

Installed by: LeVon Benton

Operation Permit by: Joe Potter date Oct 21, 99

Existing System Inspection by: date

HEALTH DEPT. COPY: WHITE INSPECTION COPY (FINAL): GREEN OWNER COPY (FINAL): YELLOW INSPECTION COPY (INITIAL): PINK OWNER COPY (INITIAL): GOLD