IREDELL COUNTY HEALTH DEPARTMENT

STATESVILLE 704-878-5305 CI MOORESVILLE 704-664-5281

IMPROVEMENT PERMIT / AUTHORIZATION TO CONSTRUCT / OPERATION PERMIT / EXISTING SYSTEM INSPECTION

PERMIT# 074528 PIN# 4629 59 6534 DATE 8-21-01

OWNER OR CONTRACTOR DAVID HUMPHREY PHONE: Cell ~~Business~~ 704-224-8716 Home 704-528-1964

ADDRESS 235 SUMMER TREE DR, TROUTMAN, NC 28166

LOCATION STATE PRK RD, (L) WILDLIFE (R) SIERRA (L) DEER RUN (R) EAGLE CHASE 3RD ON LEFT

SUBDIVISION WILDLIFE BAY BLOCK / SECTION I LOT 42 LOT AREA 47,104 sq ft SITE CLASS. PS DESIGN FLOW 480 L.T.A.R. .3

Septic Tank: 1000 Gallons; STB 1012 Date 02-07-02
Pump Tank: 1000 Gallons; PT 17 Date 02-07-02
Pump Make: MYERS Model ME50S Serial No. 25325D007
Nitrification Field: No Fields 1 Square Feet 6000/1600' Linear Feet 280'
No Lines 7 Trench Width 24" Max Trench Bottom Depth 30" Gravel Depth NA

☒ New System ☐ Repair System Type: I, II, III, (IV), V, VI
System Description: LP PANEL
Repair System Description: LP PANEL
Maintenance Agreement Required: ☒ Yes ☐ No
☐ Slab ☐ Crawl Space ☒ Basement w/plumbing ☐ Basement wo/plumbing


☒ House/Mod. Home No. Bedrooms 4
☐ Mobile Home No. Bathrooms 4
☐ Business No. Employees ___
☐ Other ___

Water Supply:
☐ Individual
☐ Public
☒ Community


Comments:/Conditions: (1) KEEP SUPPLY LINE 5' FROM PROPERTY LINE + 10' FROM BASEMENT FOUNDATION DRAIN (2) DIVERT RAIN/SURFACE H2O RUNOFF DOWN LEFT PROP LINE [redacted]

Comments:/Conditions: (3) INSTALL LINES ON CONTOURS (5) MAINTAIN SETBACKS (6) KEEP H2O LINE 10' FROM SYSTEM (7) MUST HAVE CERTIFIED OPERATOR B4 OP IS ISSUED (8) CALL FOR PUMP SIZING B-4 INSTALLATION IF WANTED.

INITIAL SITE SKETCH

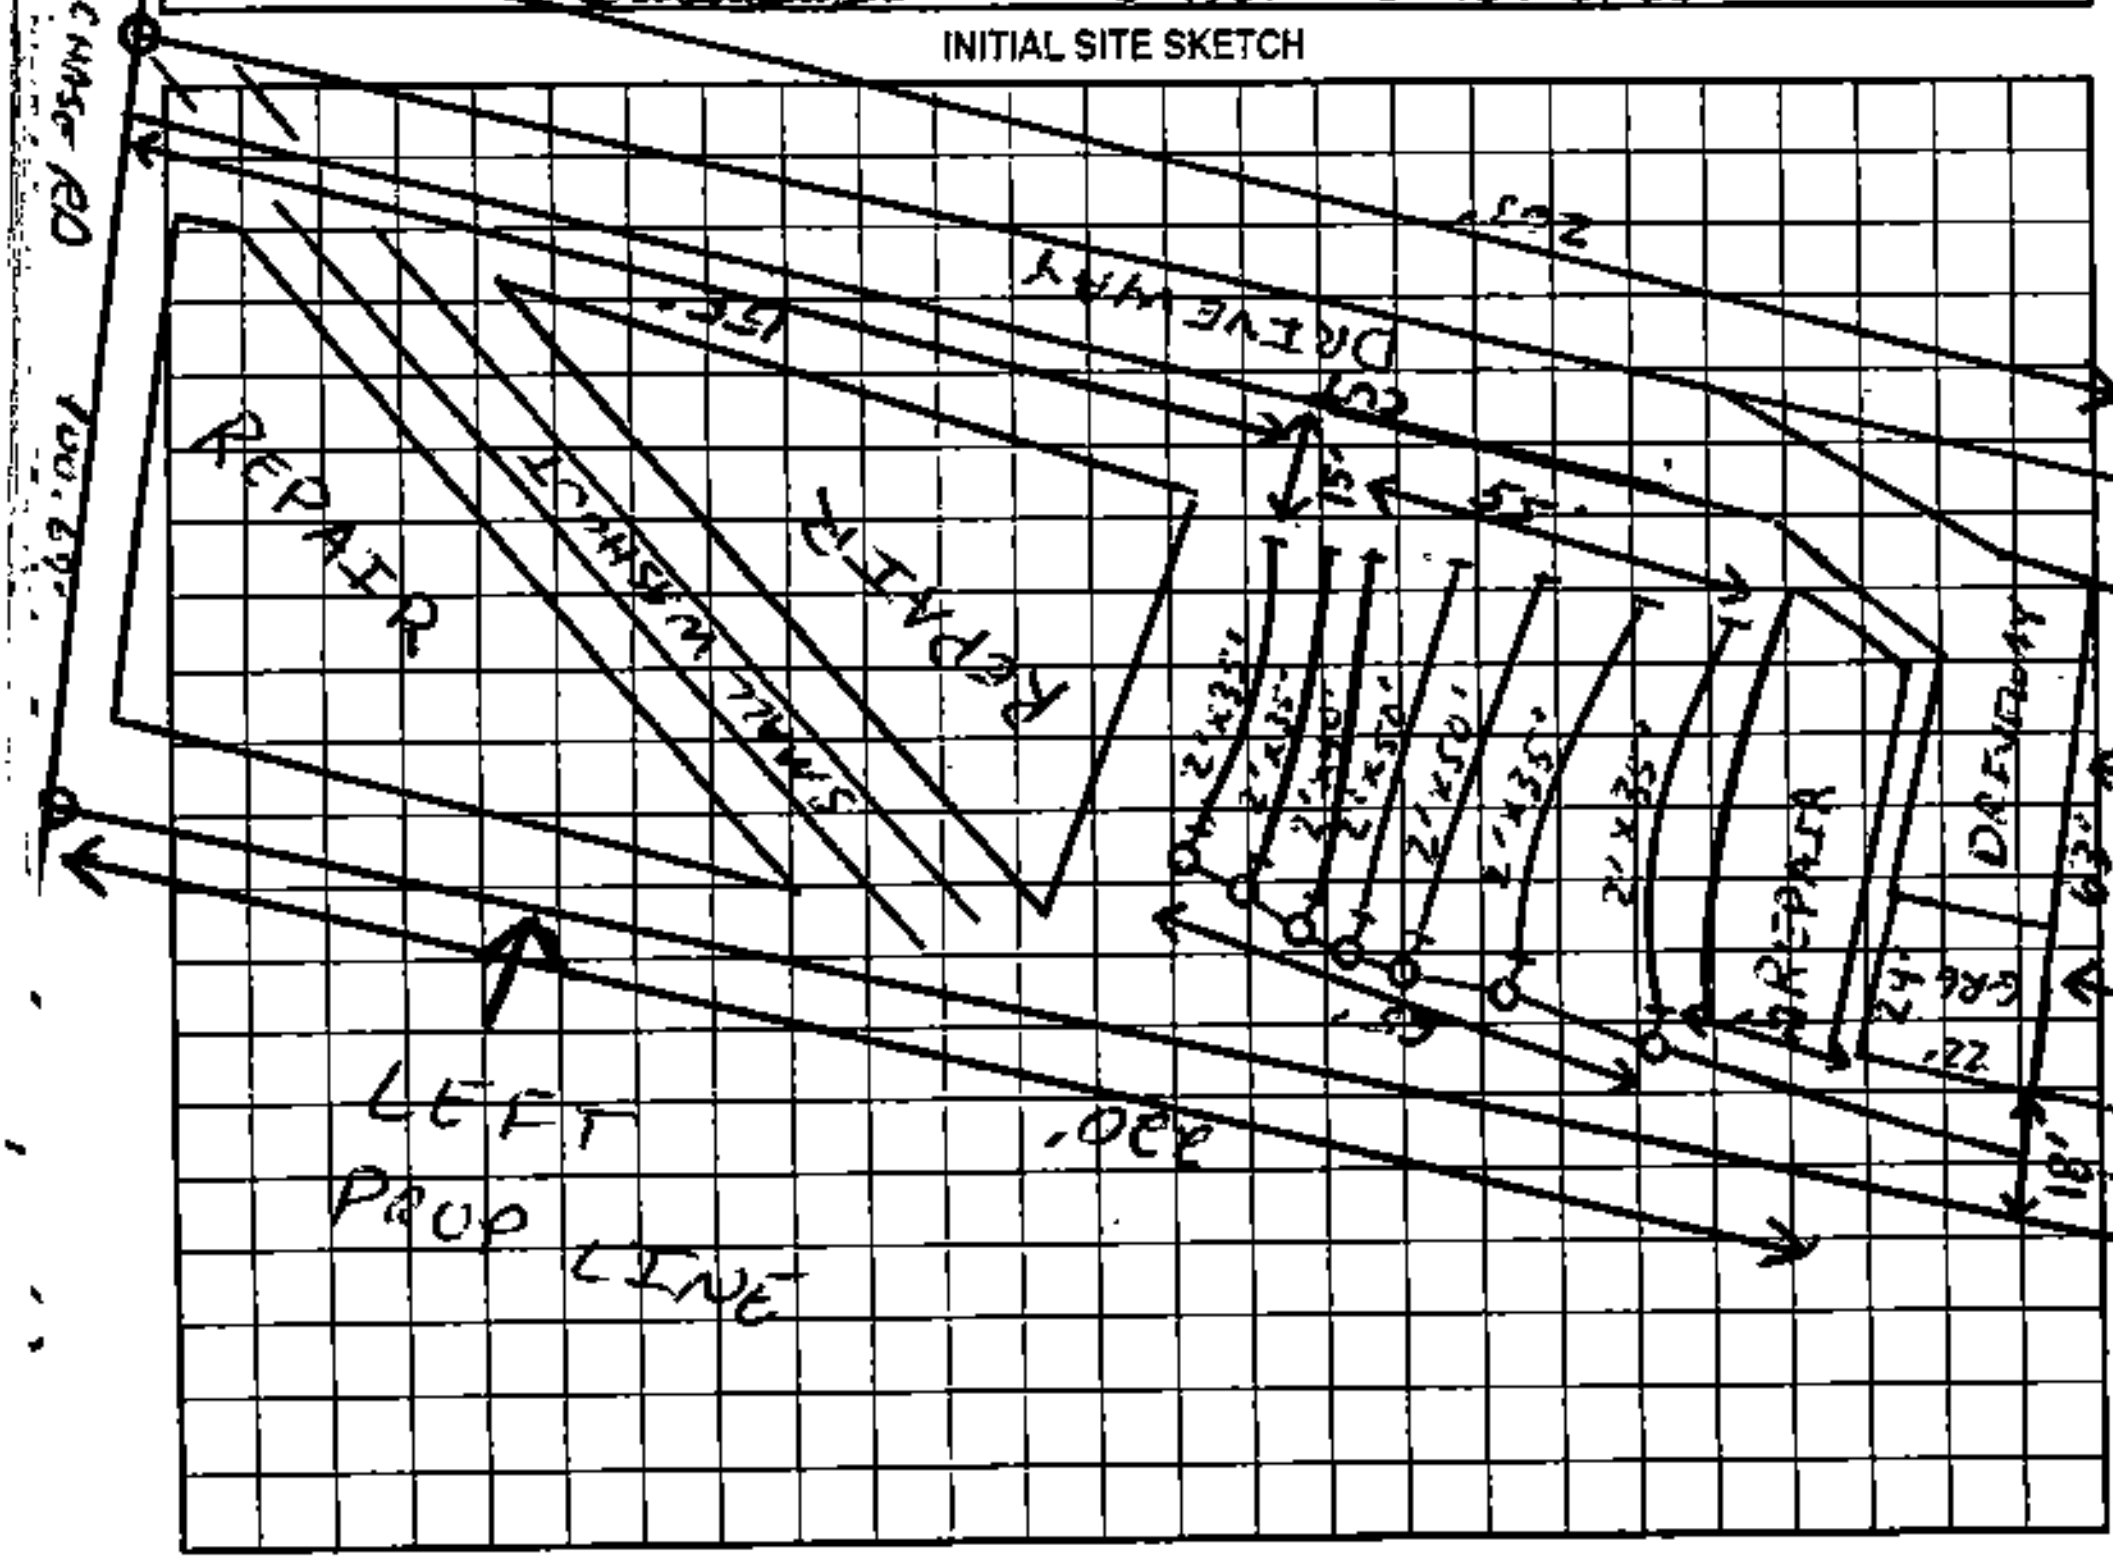

AS BUILT SKETCH

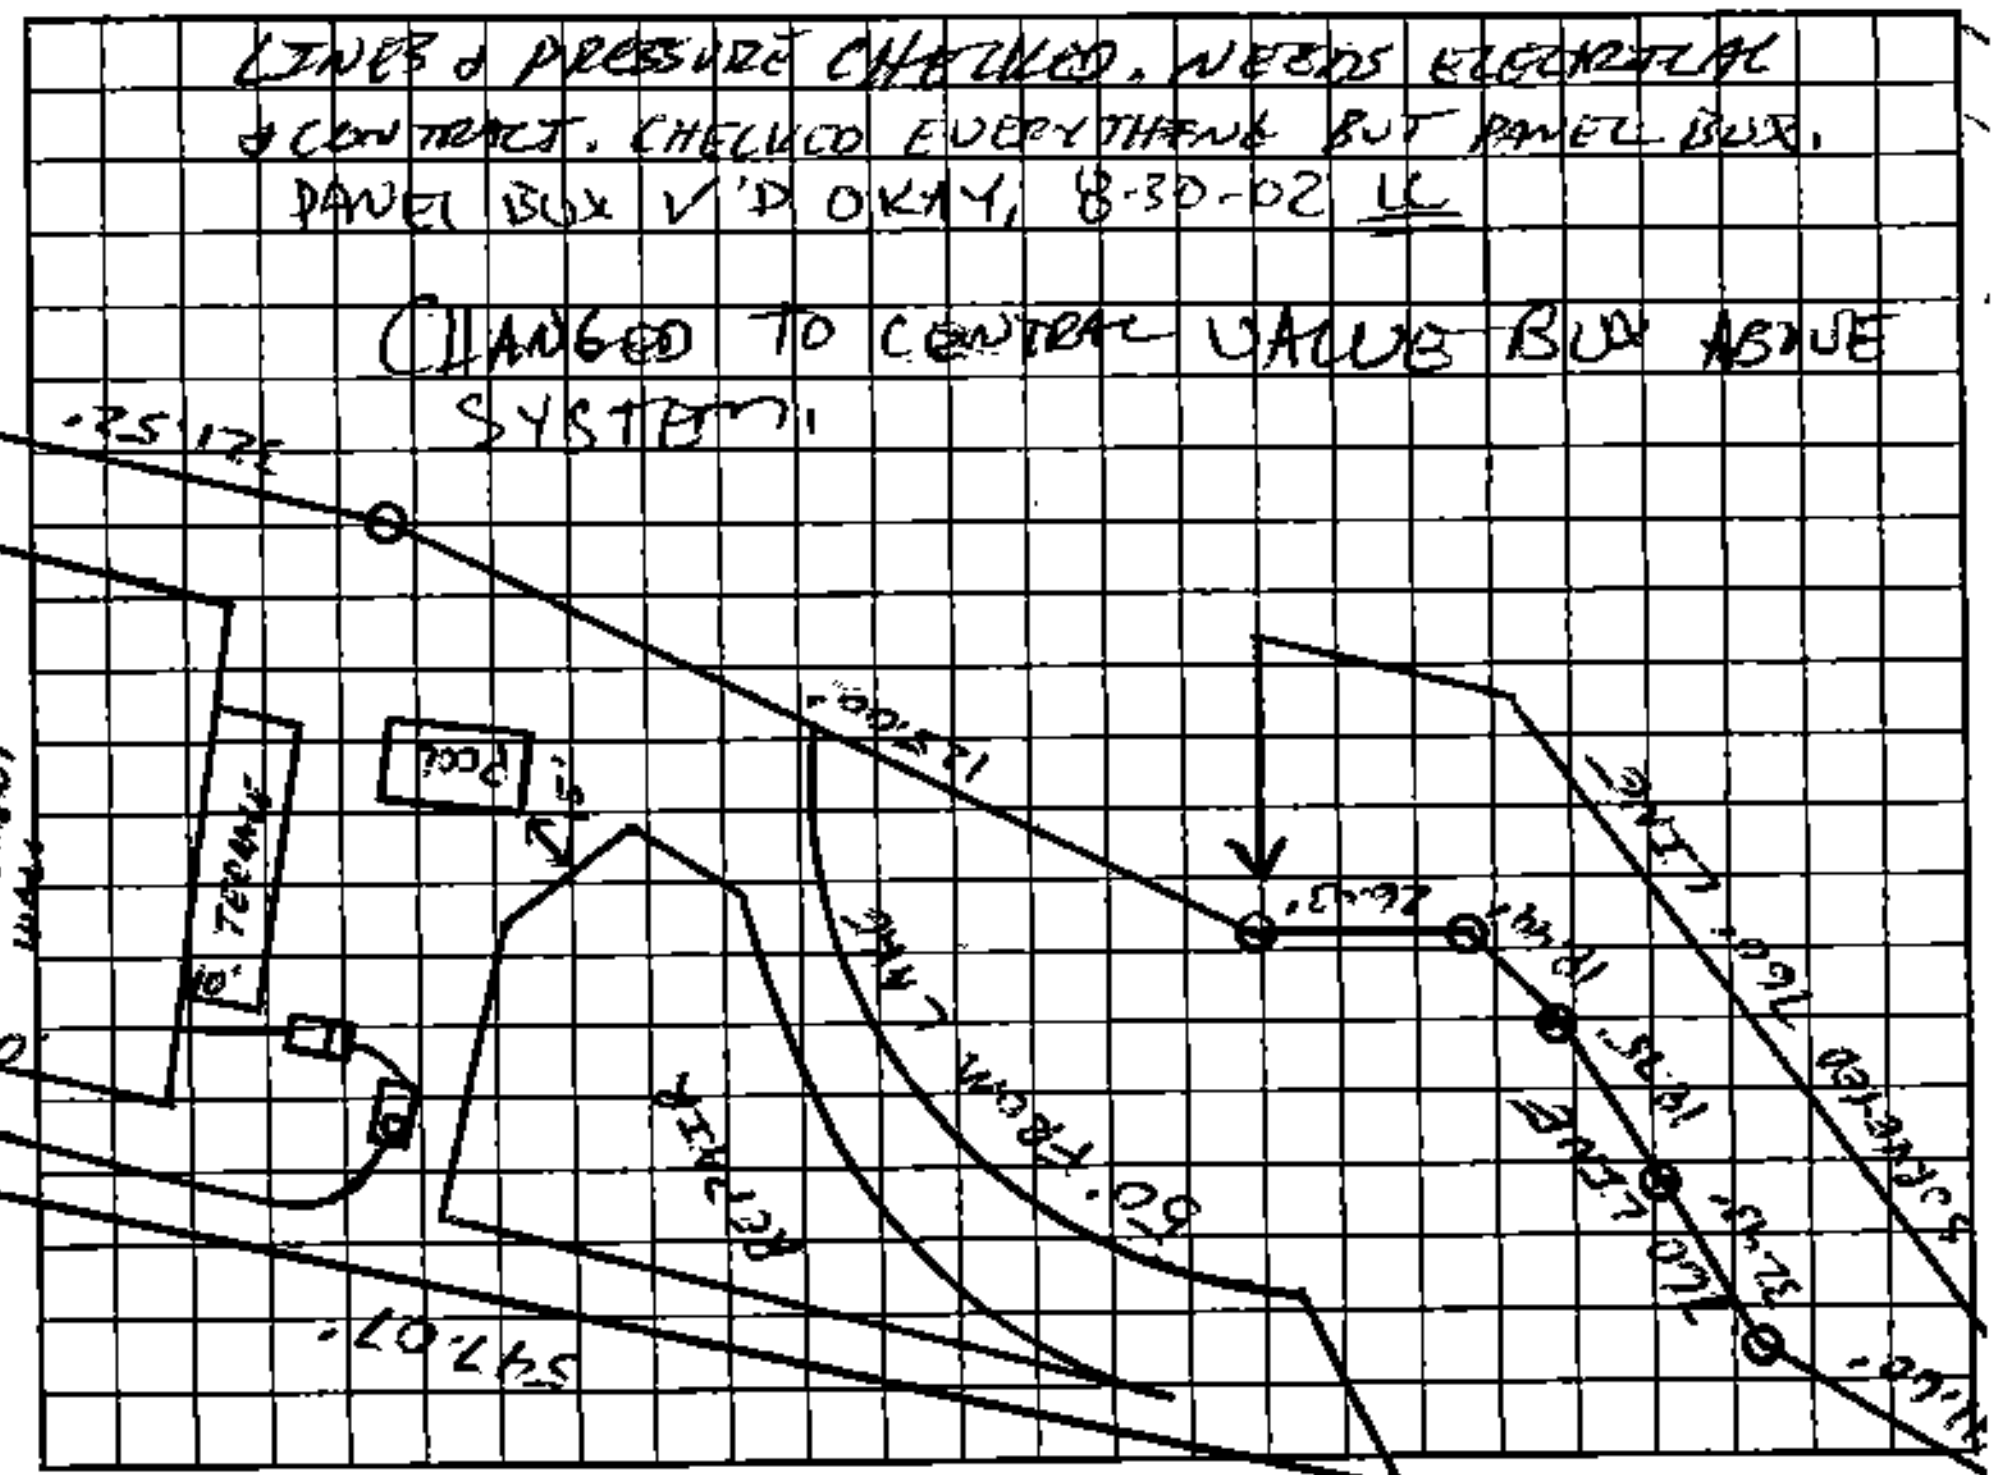

Permit can be suspended or revoked if any false information is supplied toward securing the permit/any unauthorized changes are made to the site/any unauthorized changes are made in the installation of the system. Improvement Permit with plat valid without expiration. Improvement Permit with site plan valid for sixty months. Authorization to Construct is valid for a period equal to that of Improvement Permit – not to exceed sixty months.

Signed: [signature] date 8-27-01 Installed by: A-1 BACKHOE

Improvement Permit by: [signature] RS date 8-21-01 Operation Permit by: [signature] RS date 8-30-02

Authorization to Construct by: [signature] RS date 8-21-01 Existing System Inspection by: ___ date ___

HEALTH DEPT. COPY: WHITE OWNER COPY (FINAL): YELLOW OWNER COPY (INITIAL): PINK