PERMIT ISSUED OVER ONE ISSUED 7-27-04 7-20-04 NOW VOID CI

IREDELL COUNTY HEALTH DEPARTMENT

STATESVILLE 704-878-5305 MOORESVILLE 704-664-5281

IMPROVEMENT PERMIT / AUTHORIZATION TO CONSTRUCT / OPERATION PERMIT / EXISTING SYSTEM INSPECTION

PERMIT# 122457 PIN# 4629-59-7170 DATE 7-27-04

OWNER OR CONTRACTOR NATALEE H. ERQUITT PHONE: Business _____ Home (704) 799-2658

ADDRESS 115 LYNN COVE RD MOORESVILLE NC 28117

LOCATION PERTH TO STATE PARK (L) WILDLIFE (R) SIERRA WOODS (L) DEER RUN (R) EAGLE CHASE (L) HAWK RUN @ #123 HAWK RUN

SUBDIVISION WILDLIFE BAY BLOCK / SECTION F LOT 37-37A LOT AREA 1.03 SITE CLASS PS DESIGN FLOW 480 L.T.A.R. 0.3 gpd/ft²

Septic Tank: 1000 Gallons; STB 312 Date 10-12-04
Pump Tank: 1000 Gallons; PT 27 Date 12/17 5-X-05
Pump Make: GOULDS Model WE 1512HV Serial No P05 P.S HH 15.7 MM
Nitrification Field: No Fields 1 Square Feet 1600 Linear Feet 400
No Lines 5 Trench Width 36" Max Trench Bottom Depth 36" Gravel Depth N/A

☑ New System ☐ Repair System Type: I, II, (III), IV, V, VI
System Description: PUMP 25% REDUCTION
Repair System Description: LP PPBPS 50% RED
Maintenance Agreement Required: ☐ Yes ☑ No


☑ House/Mod. Home No. Bedrooms 4
☐ Mobile Home No. Bathrooms 5
☐ Business No. Employees ____
☐ Other ____
☐ Slab ☐ Crawl Space ☑ Basement w/plumbing ☐ Basement wo/plumbing

Water Supply: ☐ Individual ☐ Public ☑ Community


Comments:/Conditions: (1) INSTALL LINES ON CONTOUR (2) SMOOTH ROUGH TOPOGRAPHY (3) MAINTAIN SETBACKS (4) CALL PRIOR TO START FOR SYSTEM SPECS & PUMP SIZING IF NECESSARY

Comments:/Conditions: OFFSITE APPEARS TO HAVE ENOUGH REPAIR AREA ABOVE & BELOW INITIAL SYSTEM
* TANKS ARE 70' TO 760 HIGH WATER MARK *

INITIAL SITE SKETCH SCALE 1" = 100'

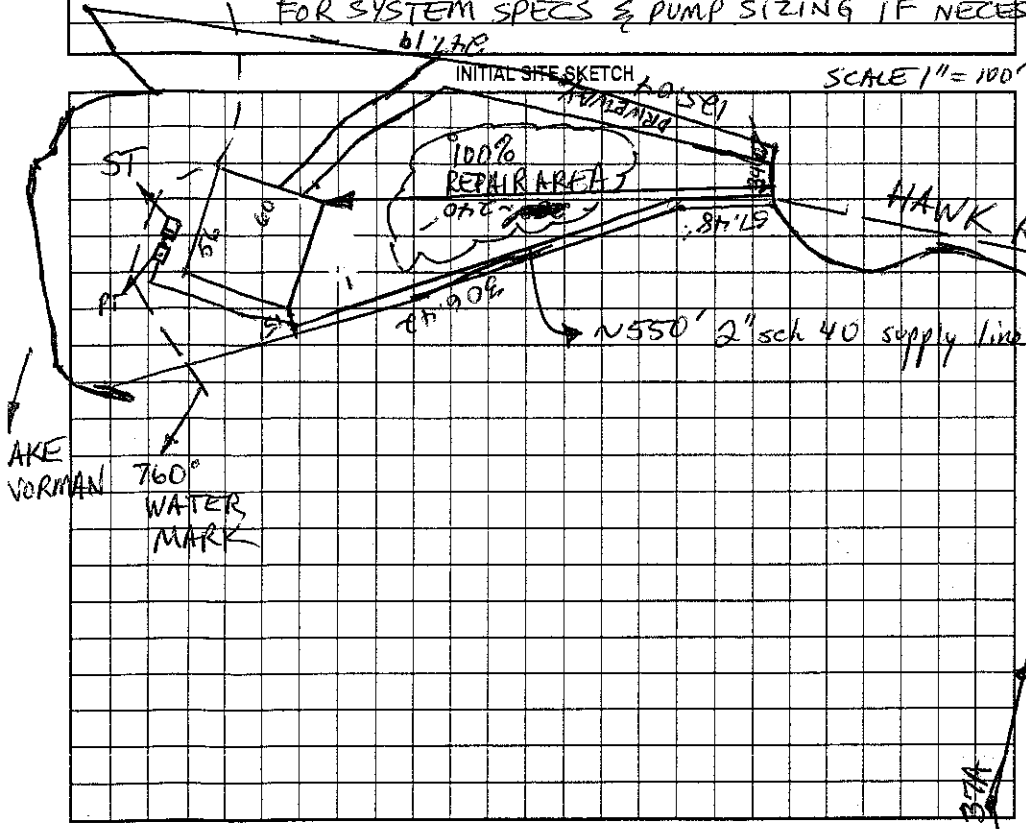

AS BUILT SKETCH

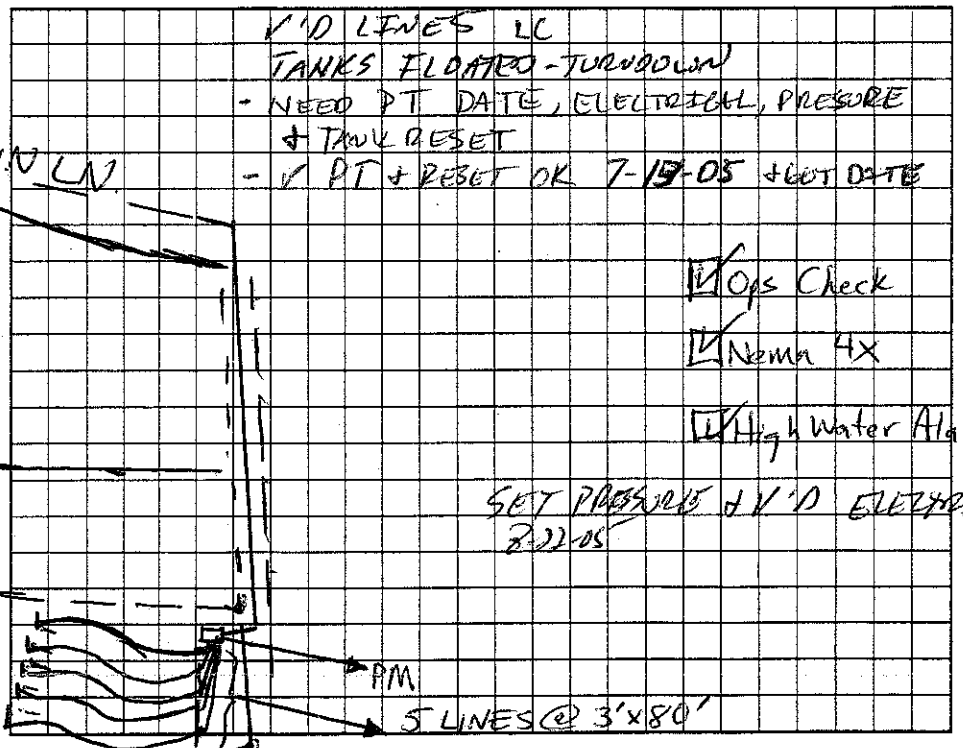

Permit can be suspended or revoked if any false information is supplied toward securing the permit/any unauthorized changes are made to the site/any unauthorized changes are made in the installation of the system. Improvement Permit with plat valid without expiration. Improvement Permit with site plan valid for sixty months. Authorization to Construct is valid for a period equal to that of Improvement Permit – not to exceed sixty months.

Signed: Natalee H Erquitt date 8-30-04 Installed by: CURT DUNNIVANT

Improvement Permit by: Christopher M. Shuler, PE date 7-27-04 Operation Permit by: _____ date 8-22-05

Authorization to Construct by: Christopher M. Shuler, PE, 8-2-04 Existing System Inspection by: _____ date _____

OWNER COPY (FINAL): YELLOW OWNER COPY (INITIAL): PINK